

<b>AMENDMENT OF SOLICITATION/MODIFICATION OF CONTRACT</b>		J	1
2. AMENDMENT/MODIFICATION NO.	3. EFFECTIVE DATE	4. REQUISITION/PURCHASE REQ. NO.	5. PROJECT NO. (If applicable)

6. ISSUED BY 0001	7. ADMINISTERED BY (If other than item 6)	8. DATE AND ZIP CODE	9. AMENDMENT OF SOLICITATION NO. W912P8-06-R-0167
CODE	CODE		CODE

USACE, CONTRACTING DIVISION  
ATTN: CEMVN-CT, ROOM 172  
7400 LEAKE AVE.  
NEW ORLEANS LA 70118-3651

See Item 6

8. DATE AND ZIP CODE	X	9A. AMENDMENT OF SOLICITATION NO. W912P8-06-R-0167
	X	9B. DATED (SEE ITEM 11) 13-Jul-2006
		10A. MOD. OF CONTRACT/ORDER NO.
		10B. DATED (SEE ITEM 13)

**11. THIS ITEM ONLY APPLIES TO AMENDMENTS OF SOLICITATIONS**

X The above numbered solicitation is amended as set forth in Item 14. The hour and date specified for receipt of Offer is extended. X is not extended.

Offer must acknowledge receipt of this amendment prior to the hour and date specified in the solicitation or as amended by one of the following methods:

(a) By completing Items 8 and 15, and returning \_\_\_\_\_ copies of the amendment; (b) By acknowledging receipt of this amendment on each copy of the offer submitted; or (c) By separate letter or telegram which includes a reference to the solicitation and amendment numbers. FAILURE OF YOUR ACKNOWLEDGMENT TO BE RECEIVED AT THE PLACE DESIGNATED FOR THE RECEIPT OF OFFERS PRIOR TO THE HOUR AND DATE SPECIFIED MAY RESULT IN REJECTION OF YOUR OFFER. If by virtue of this amendment you desire to change an offer already submitted, such change may be made by telegram or letter, provided each telegram or letter makes reference to the solicitation and this amendment, and is received prior to the opening hour and date specified.

**12. ACCOUNTING AND APPROPRIATION DATA (If required)**

**13. THIS ITEM APPLIES ONLY TO MODIFICATIONS OF CONTRACTS/ORDERS.**

IT MODIFIES THE CONTRACT/ORDER NO. AS DESCRIBED IN ITEM 14.

A. THIS CHANGE ORDER IS ISSUED PURSUANT TO: (Specify authority) THE CHANGES SET FORTH IN ITEM 14 ARE MADE IN THE CONTRACT ORDER NO. IN ITEM 10A.

B. THE ABOVE NUMBERED CONTRACT/ORDER IS MODIFIED TO REFLECT THE ADMINISTRATIVE CHANGES (such as changes in paying office, appropriation date, etc.) SET FORTH IN ITEM 14, PURSUANT TO THE AUTHORITY OF FAR 43.103(B).

C. THIS SUPPLEMENTAL AGREEMENT IS ENTERED INTO PURSUANT TO AUTHORITY OF:

D. OTHER (Specify type of modification and authority)

E. IMPORTANT: Contractor  is not,  is required to sign this document and return \_\_\_\_\_ copies to the issuing office.

**14. DESCRIPTION OF AMENDMENT/MODIFICATION (Organized by UCF section headings, including solicitation/contract subject matter where feasible.)**

The above numbered solicitation is amended to add the attached set of Plans. The proposal due date and time remains unchanged.

Except as provided herein, all terms and conditions of the document referenced in Item 9A or 10A, as applicable, apply to this contract.

15A. NAME AND TITLE OF SIGNER (Type or print)		16A. NAME AND TITLE OF CONTRACTING OFFICER (Type or print)	16B. UNITED STATES OF AMERICA
15B. CONTRACTOR/OFFEROR	15C. DATE SIGNED	16C. DATE SIGNED	
_____ (Signature of person authorized to sign)		_____ (Signature of Contracting Officer)	14-Jul-2006



PLANS FOR  
INNER HARBOR NAVIGATION CANAL  
ORLEANS PARISH, LA.

ELECTRICAL DISTRIBUTION  
INNER HARBOR NAVIGATION CANAL LOCK



U. S. ARMY  
CORPS OF ENGINEERS  
NEW ORLEANS DISTRICT  
2005




0001, PL 84-99  
W912P8-06-B-0034


FOR CONSTRUCTION  
FEB. 17, 2006

**AIMS GROUP, Inc.**  
Consulting Engineers  
4421 Zenith Street, Metairie, LA 70001  
(504) 885-7845

Safety is a Part of Your Contract

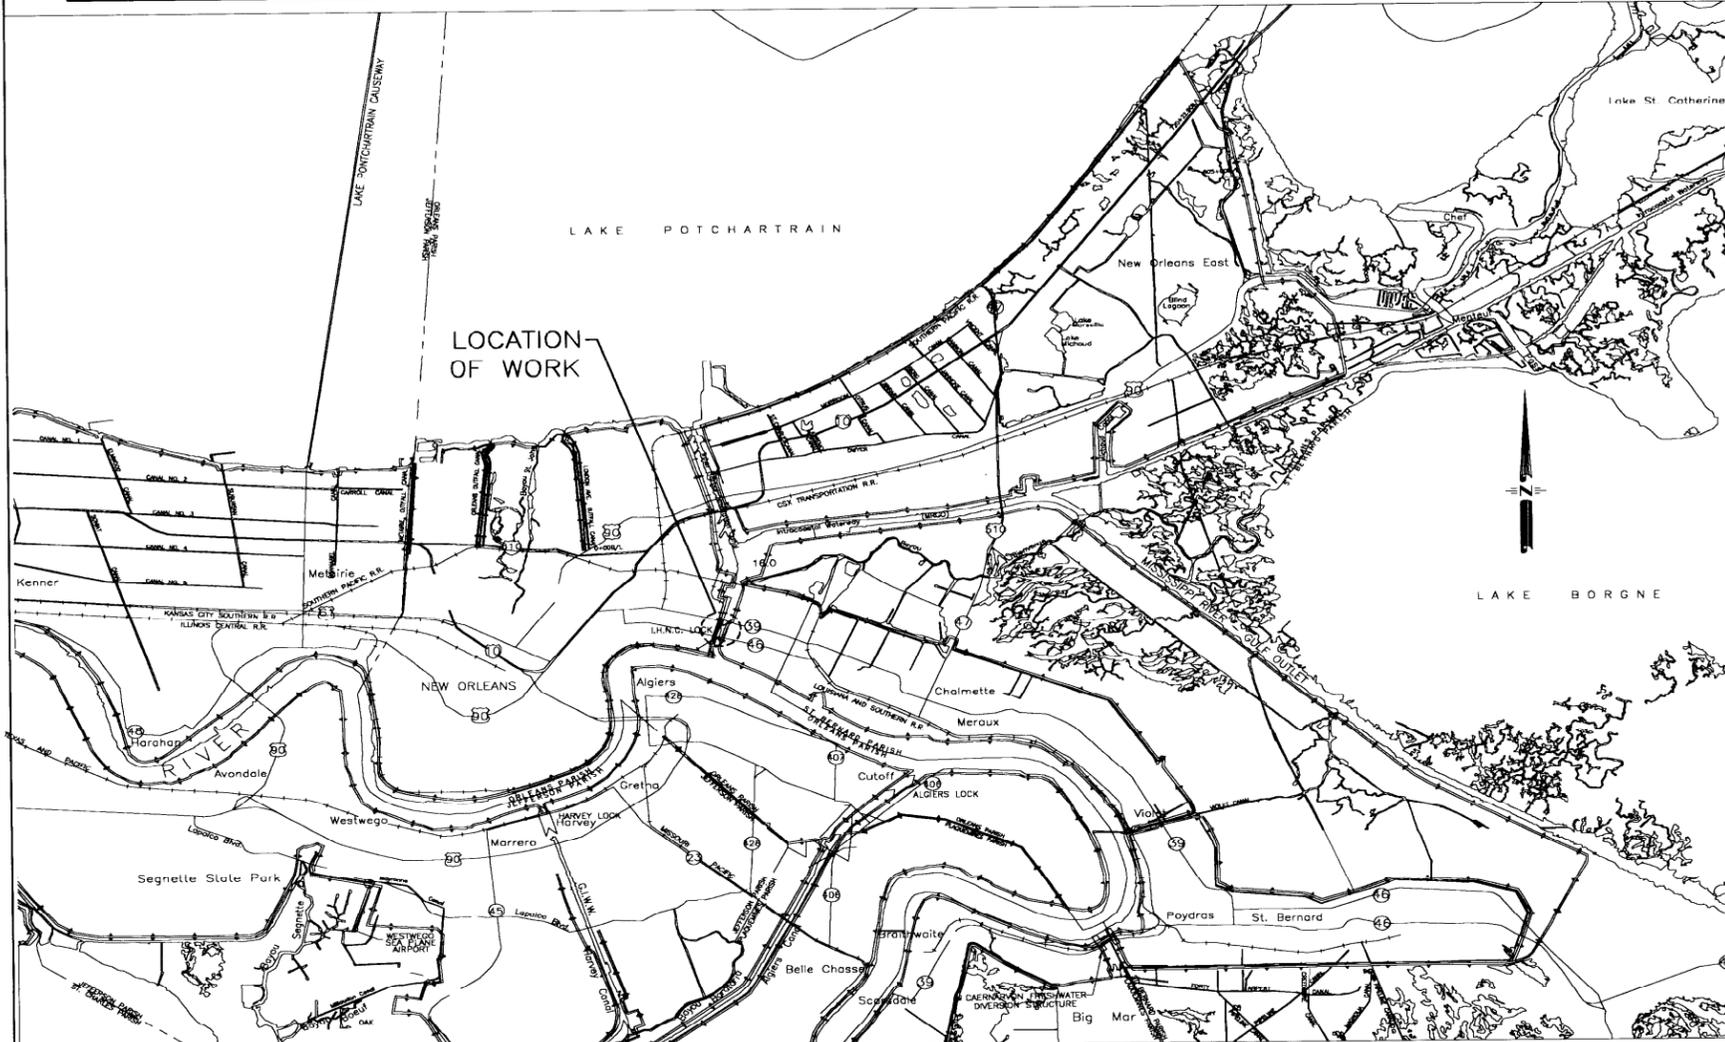


LOCATION MAP

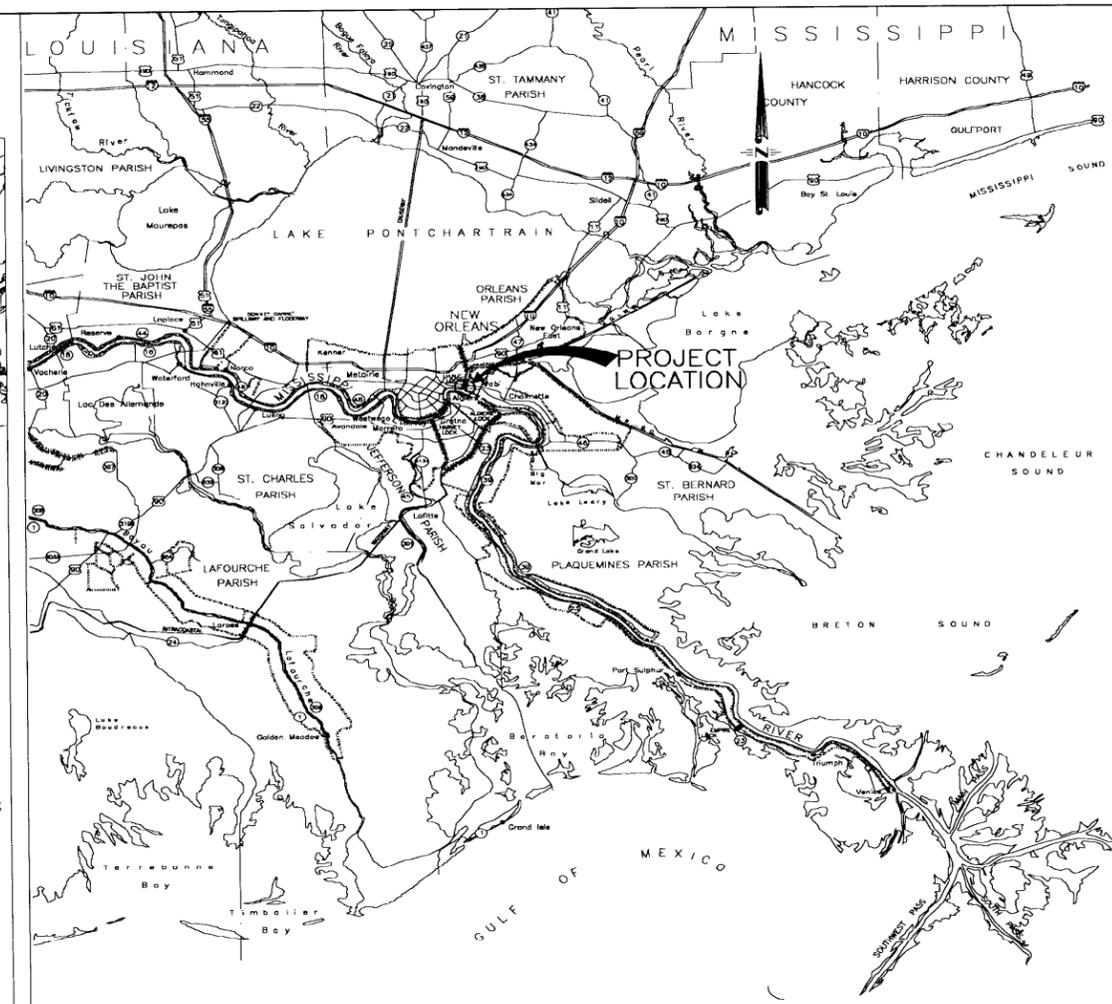

VICINITY MAP

 SCALE IN MILES



BENCH MARK DESCRIPTION		
NAME	DESCRIPTION	ELEV.
1	SHOWN ON DWG. S1	-2'-0"



This drawing has been reduced to half size

FOR CONSTRUCTION  
FEB. 17, 2006



**AIMS GROUP, Inc.**  
Consulting Engineers  
4421 Zenith Street, Metairie, LA 70001  
(504) 887-7045

INDEX TO DRAWINGS

DWG.	TITLE	DWG.	TITLE	DWG.	TITLE
1	COVER SHEET	E13	GALLERY LIGHTING/POWER PLAN		CIVIL DRAWINGS
2	VICINITY MAP, LOCATION MAP AND INDEX TO DRAWINGS	E14	EXISTING MACHINERY ROOM BRANCH CIRCUITS	C1	GENERATOR SLAB - LOCATION PLAN
		E15	ORIGINAL MITRE GATE MOTOR CONTROL DIAGRAM (GATES 1,4,5)	S1	GENERATOR SLAB & DETAILS
		E16	ORIGINAL MITRE GATE MOTOR CONTROL DIAGRAM (GATES 2, 3, 6)	S2	GENERATOR STEEL SUPPORT DETAILS
		E17	ORIGINAL MITRE GATE MOTOR CONTROL DIAGRAM (GATES 7,10)		MECHANICAL DRAWINGS
		F18	ORIGINAL MITRE GATE MOTOR CONTROL DIAGRAM (GATES 8,9)	M1	VALVE 16 AND VALVE 18 DETAILS
		E19	ORIGINAL SLUICE VALVE MOTOR CONTROL DIAGRAM	M2	SUMP PUMP DETAILS
		E20	EXISTING HYDRAULIC VALVE AND MITRE GATE MOTOR CONTROL DIAGRAMS		
		E21	SITE ELECTRICAL "AS-BUILT" MAIN ELECTRICAL ONE-LINE DIAGRAM		
		E22	EXISTING ELECTRICAL SYSTEM ONE-LINE		
		E23	REVISED ELECTRICAL SYSTEM ONE-LINE		
		E24	ELECTRICAL PANEL SCHEDULE-WEST LAKE-END		
		E25	ELECTRICAL PANEL SCHEDULES-EAST LAKE-END		
		E26	ELECTRICAL PANEL SCHEDULES-WEST RIVER-END AND GALLERY		
		E27	ELECTRICAL PANEL SCHEDULES-EAST RIVER-END AND GALLERY		
		E28	ELECTRICAL SPECIFICATION NOTES		

MARK	DESCRIPTION	DATE
	INNER HARBOR NAVIGATION CANAL ORLEANS PARISH, LA.	
	IHNC ELECTRICAL DISTRIBUTION SYSTEM INNER HARBOR NAVIGATION CANAL LOCK	
	VICINITY MAP, LOCATION MAP AND INDEX TO DRAWINGS	
	U. S. ARMY ENGINEER DISTRICT, NEW ORLEANS CORPS OF ENGINEERS NEW ORLEANS, LOUISIANA	
DESIGNED BY: E.A.B.	PLOT SCALE: 1:2	FILE NAME: IHNC INDEX(2)
CHECKED BY: T.R.L.	PLOT DATE: 2-17-06	SOLICITATION NO. W912PB-06-B-0034
DRAWN BY: S.J.B.	DATE: FEB 2006	FILE NO. 2
		DWG. 2 OF 35







Safety is a Part of Your Contract

GENERAL NOTES (MACHINERY ROOM POWER AND LIGHTING PLANS):

- 1. WHERE "XX" IS USED IN A NOTE, XX REFERS TO "NW", "NE", "SW", OR "SE", DEPENDING ON THE MACHINERY ROOM IN WHICH THE NOTE APPEARS. "NW" = NORTHWEST, OR WEST, LAKE-END "SW" = SOUTHWEST, OR WEST, RIVER-END "NE" = NORTHEAST, OR EAST, LAKE-END "SE" = SOUTHEAST, OR EAST, RIVER-END

SPECIFIC NOTES (MACHINERY ROOM POWER AND LIGHTING PLANS):

- 1. EXISTING MANHOLE ALLOWING ACCESS TO CONDUITS IN THE SLAB. UTILIZE MANHOLES TO REMOVE EXISTING CONDUITS AS INDICATED AND ONLY AFTER THE ASSOCIATED NEW CONDUITS HAVE BEEN INSTALLED AND TESTED.
- 2. MOUNT NEW, WP, GFI RECEPTACLE ADJACENT TO OR ABOVE EXISTING, CONCRETE-RECESSED RECEPTACLE. MINIMUM MOUNTING HEIGHT SHALL BE 48-INCHES ABOVE THE MACHINERY ROOM FLOOR. NO RECEPTACLE SHALL BE MOUNTED MORE THAN 72-INCHES ABOVE THE MACHINERY ROOM FLOOR. CONNECT TO NEW LIGHTING PANEL NOTED VIA SEALED, SURFACE CONDUIT. COORDINATE MOUNTING HEIGHTS WITH THE OWNER.

NUMBERS IN PARENTHESES INDICATE THE LIGHTING PANEL NUMBER AND CIRCUIT NUMBER, RESPECTIVELY. FOR EXAMPLE, (2;3) WOULD BE CIRCUIT 3 ON PANEL LL-2.

EXISTING JUNCTION BOX CONNECTING POWER FROM THE EXTERIOR MANHOLES (SEE EXISTING SITE MAIN ELECTRICAL FEEDER ONE-LINE) TO THE EXISTING BUS BARS. PROVIDE CONDUIT AND CONDUCTORS FROM EXISTING JUNCTION BOX TO NEW ECB AND PANEL HD-XX. REMOVE EXISTING CONDUIT AND CONDUCTORS FROM THE EXISTING JUNCTION BOX TO THE EXISTING BUS BARS ONCE HD-XX IS INSTALLED AND TESTED AND ALL LOADS ON THE EXISTING BUS BARS HAVE BEEN TRANSFERRED. PROVIDE GASKETED SEAL ON EXISTING JUNCTION BOX WHERE CONDUIT IS REMOVED, OR LEAVE UP TO 12-INCHES OF THE EXISTING CONDUIT AND CAP OFF AT THE END.

EXISTING EXPOSED BUS BARS TO BE REMOVED ONCE NEW DISTRIBUTION PANEL HD-XX IS INSTALLED AND ALL EXISTING LOADS ARE TRANSFERRED TO IT. REMOVE EXISTING GATE UNDER STAIR IF NECESSARY TO MAINTAIN WORKING CLEARANCE IN FRONT OF HD-XX.

EXISTING WOUND ROTOR INDUCTION MOTOR MANUFACTURED BY GE, CIRCA 1919, TO REMAIN. MOTOR OPERATES MITRE GATE. THE FOLLOWING WAS TAKEN FROM THE MOTOR NAMEPLATE:

TYPE: ITC 5013 12 52 600; HP: 52; VOLTS: 440; AMPS: 76; PHASE: 3; CYCLES: 60; SECONDARY AMPS: 120; SPEED AT FULL LOAD: 570; DESIGN D; FORM: M

REPLACE EXISTING WOUND ROTOR MOTOR CONTROLLER WITH NEW, CUSTOM FABRICATED, COMBINATION (CIRCUIT BREAKER TYPE) DISCONNECT SWITCH / MOTOR CONTROLLER PER THE BELOW.

DISCONNECTING MEANS SHALL BE LOCATED ON THE EXTERIOR OF THE CONTROL ENCLOSURE.

PROVIDE A SEPARATE 2-POLE, 20-AMP, 240-VOLT TOGGLE SWITCH INSIDE OF THE ENCLOSURE TO DISCONNECT CONTROL POWER. CONTROL POWER SHALL BE PROVIDED FROM A SEPARATE POWER SOURCE OR SHALL BE PROVIDED VIA A CONTROL TRANSFORMER CONNECTED UPSTREAM OF THE MOTOR DISCONNECT SWITCH (SO THAT CONTROLS CAN BE TESTED WHILE POWER IS DISCONNECTED FROM THE MOTOR).

FURNISH CONTROLLER / DISCONNECT WITH STAINLESS STEEL, NEMA 4X ENCLOSURE. PROVIDE SPACE HEATER AND HUMIDISTAT, WITH ASSOCIATED RELAYS AS NECESSARY, INSIDE OF THE ENCLOSURE TO PREVENT CONDENSATION. SET HUMIDISTAT CONTROLS TO 80% RH, NON-CONDENSING. MAXIMUM ENCLOSURE DIMENSIONS SHALL BE 48-INCHES WIDE BY 60-INCHES HIGH.

PROVIDE THE FOLLOWING OPERATOR INTERFACES ON THE COVER OF THE ENCLOSURE:

- 1. "HAND-OFF-AUTO" SWITCH: HEAVY DUTY, 30mm, CORROSION-RESISTANT, 3-POSITION SELECTOR SWITCH WITH ROTARY KNOB. IN THE AUTO POSITION, GATE SHALL OPERATE VIA EXISTING, EXTERNAL CONTROL INPUTS. IN THE HAND POSITION, THE "OPEN-OFF-CLOSE" SWITCH SHALL OVERRIDE EXTERNAL CONTROL INPUTS AND CONTROL GATE OPERATION.

REPLACE THE EXISTING RESISTOR BANKS CONNECTED TO THE MOTOR SECONDARY WITH NEW STAINLESS STEEL RESISTORS OF EQUAL POWER AND IMPEDANCE RATING. VERIFY RATINGS WITH ACTUAL MEASUREMENTS IN THE FIELD. RETURN THE EXISTING CAST IRON RESISTOR BANKS TO THE OWNER. LABEL THE RESISTOR BANKS WITH A TAG IDENTIFYING WHICH MOTOR IT WAS ORIGINALLY CONNECTED TO.

PROVIDE SHOP DRAWINGS FOR THE CONTROLLER AND ENCLOSURE. AT A MINIMUM, SHOP DRAWINGS SHALL CONTAIN THE FOLLOWING INFORMATION:

- 1. TO-SCALE INTERIOR COMPONENT LAYOUT DRAWING ILLUSTRATING ENCLOSURE DIMENSIONS WITH IDENTIFICATION OF (AND PLACEMENT OF) INTERIOR COMPONENTS.
- 2. TO-SCALE ELEVATION VIEW OF THE FRONT COVER ILLUSTRATING LAYOUT OF OPERATOR INTERFACES.
- 3. MOTOR CONTROL WIRING DIAGRAM INDICATING CONNECTIONS TO COMPONENTS INSIDE AND REMOTE FROM THE ENCLOSURE, INCLUDING ALL LIMIT SWITCHES, REMOTE OPERATOR CONTROLS, ETC. IDENTIFY ALL VOLTAGES, TERMINALS, WIRE SIZES, COLOR AND/OR NUMBERING IDENTIFICATION SCHEMES, COMPONENT LOCATIONS, ETC.

PROVIDE NEW CONDUIT AND CONDUCTORS TO THE CONTROLLER AS INDICATED ON THE ONE-LINE. IDENTIFY AND RECONNECT EXISTING CONTROL INPUTS.

REPLACE NON-FUNCTIONAL GATE MOTOR CONTROLLERS FIRST (GATES 3, 4, 5, 6, 9, AND 10). ONCE NON-FUNCTIONAL CONTROLLERS ARE REPLACED AND TESTED (AND THE LOCK CAN BE OPERATED WITH THE NEW CONTROLLERS), REPLACE THE EXISTING, FUNCTIONAL MOTOR CONTROLLERS (GATES 1, 2, 7, AND 8).

REMOVE EXISTING CONDUCTORS TO MOTOR PRIMARY AND SECONDARY WINDINGS AND TO SOLENOID BRAKE. ROUTE NEW CONDUIT AND CONDUCTORS OVERHEAD FROM THE NEW MOTOR CONTROLLER TO THE EXISTING MOTOR POWER FOR THE SOLENOID BRAKE SHALL COME FROM THE MOTOR'S PRIMARY WINDING FEEDER. SEE TYPICAL WOUND ROTOR MOTOR / CONTROLLER CONDUIT CONNECTION DETAIL. MAKE FINAL TERMINATIONS TO MOTOR AND BRAKE WITH LFMC (LESS THAN 6-FEET).

EXISTING HYDRAULIC GATE VALVE MOTOR MANUFACTURED BY BALDOR TO REMAIN. THE FOLLOWING WAS TAKEN FROM THE MOTOR NAMEPLATE: MODEL # CM2333T; 15HP; 480-VOLTS; 3-PHASE; 60-HZ; 19.2-AMPS; 1760 RPM; 254TC FRAME; 1.15 SERVICE FACTOR; CODE H; DESIGN B; CLASS F; 91% EFF.; 0.8 POWER FACTOR; CONTINUOUS RATED AT 40-DEGREES C AMBIENT; TEFC

REMOVE EXISTING MOTOR CONTROLLER FOR VALVE MOTOR. REPLACE CONTROLLER WITH NEW COMBINATION (CIRCUIT BREAKER TYPE) DISCONNECT SWITCH / MOTOR CONTROLLER. CONTROLLER SHALL BE 3-POLE, 480-VOLT, WITH CIRCUIT BREAKER, FVNR STARTER AND SOLID STATE OVERLOAD RELAYS INSIDE OF A NEMA 4X STAINLESS STEEL ENCLOSURE. DISCONNECTING MEANS SHALL BE LOCATED ON THE EXTERIOR OF THE CONTROL ENCLOSURE.

MONITOR, AND SHUT MOTOR DOWN UPON, THE FOLLOWING CONDITIONS: MOTOR OVERLOAD, PHASE LOSS, PHASE REVERSAL, PHASE UNBALANCE, GROUND FAULT.

PROVIDE THE FOLLOWING OPERATOR INTERFACES ON THE COVER OF THE ENCLOSURE:

- 1. "HAND-OFF-AUTO" SWITCH: HEAVY DUTY, 30mm, CORROSION-RESISTANT, 3-POSITION SELECTOR SWITCH WITH ROTARY KNOB. IN THE AUTO POSITION, VALVE SHALL OPERATE VIA EXISTING, EXTERNAL CONTROL INPUTS. IN THE HAND POSITION, THE "OPEN-OFF-CLOSE" SWITCH SHALL OVERRIDE EXTERNAL CONTROL INPUTS AND CONTROL VALVE OPERATION.
- 2. "OPEN-OFF-CLOSE" SWITCH: HEAVY DUTY, 30mm, CORROSION-RESISTANT, 3-POSITION SELECTOR SWITCH WITH ROTARY KNOB. WHEN THE "HAND-OFF-AUTO" SWITCH IS IN THE HAND POSITION, THE "OPEN-OFF-CLOSE" SWITCH CONTROLS THE OPERATION OF THE MOTOR. LIMIT SWITCHES, OVERLOADS, INTERLOCKS AND SAFETIES SHALL NOT BE BYPASSED BY THE "OPEN-OFF-CLOSE" SWITCH.
- 3. VALVE CLOSED LAMP: LED OR LONG-LIFE INCANDESCENT LAMP WITH SERIES-CONNECTED RESISTOR; AMBER LENS; ON WHENEVER CLOSED LIMIT SWITCH INDICATES THAT THE VALVE IS CLOSED.
- 4. VALVE OPEN LAMP: LED OR LONG-LIFE INCANDESCENT LAMP WITH SERIES-CONNECTED RESISTOR; AMBER LENS; ON WHENEVER OPEN LIMIT SWITCH INDICATES THAT THE VALVE IS OPEN.
- 5. MOTOR OVERLOAD LAMP: LED OR LONG-LIFE INCANDESCENT LAMP WITH SERIES-CONNECTED RESISTOR, RED LENS; ON WHENEVER POWER IS REMOVED FROM THE MOTOR BECAUSE OF AN OVERLOAD CONDITION.

PROVIDE NEW CONDUIT AND CONDUCTORS TO CONTROLLER AS INDICATED ON THE REVISED ONE-LINE. RECONNECT EXISTING CONTROL INPUTS.

EXISTING WOUND ROTOR INDUCTION MOTOR MANUFACTURED BY GE, CIRCA 1919, WITH NAMEPLATE IDENTICAL TO THAT OF THE GATE MOTORS, TO BE REMOVED BY THE CORPS OF ENGINEERS. NEW SUMP PUMP AND ASSOCIATED CONTROL DEVICES (FLOAT SWITCHES, ETC.) AND PANEL SHALL BE FURNISHED AND INSTALLED BY OTHERS. PROVIDE NEW CONDUIT AND CONDUCTORS, AND MAKE FINAL POWER TERMINATIONS, TO NEW PUMP AND CONTROL PANEL AS INDICATED HEREIN. SEE MECHANICAL PLANS.

REMOVE EXISTING WOUND ROTOR MOTOR CONTROLLER FOR VALVE MOTOR. INSTALL NEW 3-POLE, 60-AMP, 480-VOLT, FUSED DISCONNECT IN NEMA 4X STAINLESS STEEL ENCLOSURE FOR NEW SUMP PUMP.

PROVIDE NEW CONDUIT AND CONDUCTORS TO SWITCH AND CONTROLLER AS INDICATED ON THE ONE-LINE.

REMOVE EXISTING CONDUCTORS TO VALVE MOTORS. ROUTE NEW CONDUIT AND CONDUCTORS OVERHEAD FROM THE NEW MOTOR CONTROLLERS AS INDICATED ON THE ONE-LINE. SEE MOTOR / CONTROLLER CONDUIT CONNECTION DETAILS. MAKE FINAL TERMINATIONS TO MOTOR WITH LFMC (LESS THAN 6-FEET).

EXISTING SUMP PUMP AND ASSOCIATED CONTROL DEVICES (FLOAT SWITCHES, ETC.) AND PANEL TO BE REPLACED BY OTHERS. PROVIDE NEW CONDUIT AND CONDUCTORS, AND MAKE FINAL POWER TERMINATIONS, TO NEW PUMP AND NEW CONTROL PANEL AS INDICATED HEREIN. SEE MECHANICAL PLANS.

REMOVE EXISTING DISCONNECT SWITCH AND PUMP STARTER. INSTALL NEW 3-POLE, 60-AMP, 480-VOLT, FUSED DISCONNECT IN NEMA 4X STAINLESS STEEL ENCLOSURE FOR NEW SUMP PUMP.

PROVIDE NEW CONDUIT AND CONDUCTORS TO SWITCH AND CONTROLLER AS INDICATED ON THE ONE-LINE.

EXISTING WOUND ROTOR INDUCTION MOTOR MANUFACTURED BY GE, CIRCA 1919, WITH NAMEPLATE IDENTICAL TO THAT OF THE GATE MOTORS, FOR EXISTING CAPSTAN. CAPSTANS ARE NO LONGER USED. ABANDON EXISTING WIRING, CONDUITS, CONTROLLER, AND MOTOR IN PLACE.

REMOVE EXISTING DEDICATED RECEPTACLE AND ASSOCIATED CONDUIT AND CONDUCTORS.

REMOVE EXISTING DISCONNECT SWITCH / ENCLOSED CIRCUIT BREAKER. RE-FEED LOADS AS INDICATED ON ONE LINE.

PROVIDE A NEMA 4X, STAINLESS STEEL, 2-POLE, 60-AMP (FUSE AT 50-AMPS), FUSED DISCONNECT SWITCH FOR DEDICATED 50-AMP PORTABLE PUMP RECEPTACLE. BELOW SWITCH, PROVIDE A DEDICATED, MARINE-GRADE, CORROSION-RESISTANT, 50-AMP, 120/240-VOLT, 3-POLE, 4-WIRE, GROUNDING-TYPE, SURFACE-MOUNTED, WEATHERPROOF RECEPTACLE / POWER INLET. COORDINATE RECEPTACLE / POWER INLET REQUIREMENTS WITH THE OWNER PRIOR TO PURCHASE AND INSTALLATION.

REMOVE EXISTING TRANSFORMER AND ALL ASSOCIATED CONDUIT AND CONDUCTORS. RE-FEED LOADS AS INDICATED ON ONE-LINE.

EXISTING MITRE GATE WOUND ROTOR INDUCTION MOTOR (IDENTICAL TO THE OTHER MITRE GATE MOTORS) IN LOWER ELEVATION TO BE REWOUND, RECONDITIONED, AND TESTED BY A GE, ISO 9001, AND NEMA APPROVED MOTOR SHOP. THE REWINDING AND REFURBISHING PROCESS SHALL, AT A MINIMUM, ADHERE TO THE ONE SPECIFIED ON THESE DRAWINGS.

ALTERNATE CIRCUITS BETWEEN FIXTURES.

EXISTING WOUND ROTOR INDUCTION MOTOR MANUFACTURED BY GE, CIRCA 1919, WITH NAMEPLATE IDENTICAL TO THAT OF THE GATE MOTORS, TO REMAIN.

REPLACE EXISTING WOUND ROTOR MOTOR CONTROLLER WITH NEW, CUSTOM FABRICATED, COMBINATION (CIRCUIT BREAKER TYPE) DISCONNECT SWITCH / MOTOR CONTROLLER PER THE BELOW.

DISCONNECTING MEANS SHALL BE LOCATED ON THE EXTERIOR OF THE CONTROL ENCLOSURE.

PROVIDE A SEPARATE 2-POLE, 20-AMP, 240-VOLT TOGGLE SWITCH INSIDE OF THE ENCLOSURE TO DISCONNECT CONTROL POWER. CONTROL POWER SHALL BE PROVIDED FROM A SEPARATE POWER SOURCE OR SHALL BE PROVIDED VIA A CONTROL TRANSFORMER CONNECTED UPSTREAM OF THE MOTOR DISCONNECT SWITCH (SO THAT CONTROLS CAN BE TESTED WHILE POWER IS DISCONNECTED FROM THE MOTOR).

FURNISH CONTROLLER / DISCONNECT WITH STAINLESS STEEL, NEMA 4X ENCLOSURE. PROVIDE SPACE HEATER AND HUMIDISTAT, WITH ASSOCIATED RELAYS AS NECESSARY, INSIDE OF THE ENCLOSURE TO PREVENT CONDENSATION. SET HUMIDISTAT CONTROLS TO 80% RH, NON-CONDENSING. MAXIMUM ENCLOSURE DIMENSIONS SHALL BE 48-INCHES WIDE BY 60-INCHES HIGH.

PROVIDE THE FOLLOWING OPERATOR INTERFACES ON THE COVER OF THE ENCLOSURE:

- 1. "HAND-OFF-AUTO" SWITCH: HEAVY DUTY, 30mm, CORROSION-RESISTANT, 3-POSITION SELECTOR SWITCH WITH ROTARY KNOB. IN THE AUTO POSITION, VALVE SHALL OPERATE VIA EXISTING, EXTERNAL CONTROL INPUTS. IN THE HAND POSITION, THE "OPEN-OFF-CLOSE" SWITCH SHALL OVERRIDE EXTERNAL CONTROL INPUTS AND CONTROL VALVE OPERATION.
- 2. "OPEN-OFF-CLOSE" SWITCH: HEAVY DUTY, 30mm, CORROSION-RESISTANT, 3-POSITION SELECTOR SWITCH WITH ROTARY KNOB. WHEN THE "HAND-OFF-AUTO" SWITCH IS IN THE HAND POSITION, THE "OPEN-OFF-CLOSE" SWITCH CONTROLS THE OPERATION OF THE MOTOR. LIMIT SWITCHES, OVERLOADS, INTERLOCKS AND SAFETIES SHALL NOT BE BYPASSED BY THE "OPEN-OFF-CLOSE" SWITCH.
- 3. VALVE CLOSED LAMP: LED OR LONG-LIFE INCANDESCENT LAMP WITH SERIES-CONNECTED RESISTOR; AMBER LENS; ON WHENEVER CLOSED LIMIT SWITCH INDICATES THAT THE VALVE IS CLOSED.
- 4. VALVE OPEN LAMP: LED OR LONG-LIFE INCANDESCENT LAMP WITH SERIES-CONNECTED RESISTOR; AMBER LENS; ON WHENEVER OPEN LIMIT SWITCH INDICATES THAT THE VALVE IS OPEN.
- 5. MOTOR OVERLOAD LAMP: LED OR LONG-LIFE INCANDESCENT LAMP WITH SERIES-CONNECTED RESISTOR, RED LENS; ON WHENEVER POWER IS REMOVED FROM THE MOTOR BECAUSE OF AN OVERLOAD CONDITION.

REPLACE THE EXISTING RESISTOR BANKS CONNECTED TO THE MOTOR SECONDARY WITH NEW STAINLESS STEEL RESISTORS OF EQUAL POWER AND IMPEDANCE RATING. VERIFY RATINGS WITH ACTUAL MEASUREMENTS IN THE FIELD. RETURN THE EXISTING CAST IRON RESISTOR BANKS TO THE OWNER. LABEL THE RESISTOR BANKS WITH A TAG IDENTIFYING WHICH MOTOR IT WAS ORIGINALLY CONNECTED TO.

PROVIDE SHOP DRAWINGS FOR THE CONTROLLER AND ENCLOSURE. AT A MINIMUM, SHOP DRAWINGS SHALL CONTAIN THE FOLLOWING INFORMATION:

- 1. TO-SCALE INTERIOR COMPONENT LAYOUT DRAWING ILLUSTRATING ENCLOSURE DIMENSIONS WITH IDENTIFICATION OF (AND PLACEMENT OF) INTERIOR COMPONENTS.
- 2. TO-SCALE ELEVATION VIEW OF THE FRONT COVER ILLUSTRATING LAYOUT OF OPERATOR INTERFACES.
- 3. MOTOR CONTROL WIRING DIAGRAM INDICATING CONNECTIONS TO COMPONENTS INSIDE AND REMOTE FROM THE ENCLOSURE, INCLUDING ALL LIMIT SWITCHES, REMOTE OPERATOR CONTROLS, ETC. IDENTIFY ALL VOLTAGES, TERMINALS, WIRE SIZES, COLOR AND/OR NUMBERING IDENTIFICATION SCHEMES, COMPONENT LOCATIONS, ETC.

PROVIDE NEW CONDUIT AND CONDUCTORS TO THE CONTROLLER AS INDICATED ON THE ONE-LINE. IDENTIFY AND RECONNECT EXISTING CONTROL INPUTS.

PROVIDE JB WITH WEATHERPROOF SWITCH TO FEED SHAFT LIGHT AND RECEPTACLE. RECEPTACLE SHALL BE CORROSION-RESISTANT, MARINE-GRADE. ENCLOSURE SHALL BE WATER-TIGHT. SEE SHAFT LIGHTING DETAIL ON SHEET E5.

REPLACE EXISTING DISCONNECT SWITCH WITH A NEW NEMA 4X STAINLESS STEEL FUSED DISCONNECT SWITCH. NEW SWITCH SHALL MATCH THE SIZE, VOLTAGE, AND AMP RATING OF THE ONE REPLACED, UNLESS NOTED OTHERWISE. RECONNECT EXISTING LOAD, UNLESS NOTED OTHERWISE.

INSTALL NEW MINI-POWER ZONE ADJACENT TO EXISTING RECESSED PANEL. ROUTE SURFACE CONDUIT AND CONDUCTORS TO POWER CENTER AS INDICATED ON THE ONE-LINE. PROVIDE NEW BRANCH CIRCUIT WIRING AND CONDUIT TO MACHINERY ROOM / GALLERY LIGHTS AND RECEPTACLES AS INDICATED ON THE MACHINERY ROOM AND GALLERY PLANS. REMOVE BREAKERS IN THE EXISTING PANEL AS LOADS ARE TRANSFERRED TO THE POWER CENTER. MAXIMUM MINI-POWER ZONE DIMENSIONS SHALL BE 18-INCHES WIDE BY 48-INCHES HIGH.

TRACE-OUT AND RE-FEED (OR ABANDON IF ALLOWED) ANY REMAINING CIRCUITS IN THE EXISTING PANEL THAT ARE NOT FOR MACHINERY ROOM LIGHTS OR RECEPTACLES. UTILIZE SPARE BREAKERS IN THE POWER CENTER TO RE-FEED EXISTING CIRCUITS. NOTIFY ENGINEER OF CIRCUITS TO BE RE-FEED PRIOR TO PERFORMING WORK. PLACE A 24-INCH BY 24-INCH JUNCTION BOX OVER THE EXISTING RECESSED PANEL TO RE-FEED CIRCUITS. ONCE ALL EXISTING PANEL LOADS HAVE BEEN RE-FEED OR ABANDONED, PLACE BLANK COVER OVER EXISTING PANEL / JUNCTION BOX.

FURNISH AND INSTALL NEW ECB AND PANEL HD-XX PER THE PANEL SCHEDULE. MAXIMUM ECB DIMENSIONS SHALL BE 18-INCHES WIDE BY 48-INCHES HIGH. MAXIMUM HD-XX DIMENSIONS SHALL BE 48-INCHES WIDE BY 68-INCHES HIGH. FIELD VERIFY DIMENSIONS PRIOR TO INSTALLATION.

REMOVE EXISTING 60-AMP FUSED DISCONNECT SWITCH FEEDING 25 KVA TRANSFORMER SERVING EXISTING 200-AMP, 120/240-VOLT PANEL "LXX". TEMPORARILY RE-FEED EXISTING TRANSFORMER FROM HD-XX UNTIL TRANSFORMER IS REPLACED.

REPLACE EXISTING 25KVA TRANSFORMER AND ADJACENT EXISTING PANEL "LXX" WITH NEW MINI-POWER ZONE LD-XX AS SCHEDULED. RECONNECT EXISTING CIRCUITS TO NEW PANEL. TRACE OUT UNIDENTIFIED EXISTING CIRCUITS AND PROPERLY LABEL THE PANEL SCHEDULE. MAXIMUM MINI-POWER ZONE DIMENSIONS SHALL BE 18-INCHES WIDE BY 48-INCHES HIGH.

RECONNECT EXISTING 120-VOLT, 175-WATT FLOODLIGHT TO PANEL LD-XX. ROUTE 2#12, #12 GROUND IN LFMC TO INSIDE OF THE MACHINERY ROOM. PROVIDE A JUNCTION BOX AND THEN ROUTE CONDUCTORS IN RIGID CONDUIT BACK TO PANEL. ROUTE THROUGH LIGHTING CONTACTOR PANEL. SEE PANEL SCHEDULES.

SPECIFIC NOTES (WEST LAKE-END MACHINERY ROOM POWER):

- NOT USED.
- REPLACE EXISTING PANEL "11N" WITH NEW MINI-POWER ZONE "LL-11N" (AS SCHEDULED). ROUTE SURFACE CONDUIT AND CONDUCTORS TO "LL-11N" AS INDICATED ON THE ONE-LINE. RECONNECT EXISTING CIRCUITS AND PROVIDE NEW BRANCH CIRCUIT WIRING AND CONDUIT TO LOWER ELEVATION MACHINERY ROOM LIGHTS AND RECEPTACLES AS INDICATED ON THE MACHINERY ROOM PLANS.
- REMOVE EXISTING TRANSFORMER AND DISCONNECT SWITCH. RECONNECT TRANSFORMER SECONDARY CIRCUITS TO NEW PANEL "LD-NW" TO FEED THE NORTH OPERATOR SHACK.
- EXISTING 300 HP MOTOR MANUFACTURED BY WESTINGHOUSE, CIRCA 1919, FOR EXISTING DE-WATERING PUMP. PUMP IS NO LONGER USED. ABANDON EXISTING WIRING, CONDUITS, CONTROLLER, AND MOTOR IN PLACE.
- REPLACE EXISTING TROUGH DOWN STAIRS AND ALONG WALL WITH CONDUITS AS NECESSARY TO RE-FEED GATE MOTOR AND PANEL "LL-11N" LOADS. SEE ONE-LINE.
- PROVIDE 200-AMP, NON-FUSED, NEMA 4X STAINLESS STEEL DISCONNECT SWITCH FOR GATE MOTOR.
- EXISTING AIR COMPRESSOR TO REMAIN.
- PROVIDE NEW 30-AMP, NEMA 4X, STAINLESS STEEL, FUSED DISCONNECT SWITCH FOR AIR COMPRESSOR. MAKE FINAL CONNECTIONS FROM DISCONNECT TO COMPRESSOR WITH LFMC.
- EXISTING WATER HEATER TO REMAIN.
- PROVIDE NEW 30-AMP, NEMA 4X, STAINLESS STEEL, FUSED DISCONNECT SWITCH FOR WATER HEATER. MAKE FINAL CONNECTIONS FROM DISCONNECT TO WATER HEATER WITH LFMC.
- REMOVE PUMP CONTROLLER AND RETURN TO THE OWNER ONCE NEW SUMP PUMP IS INSTALLED AND TESTED.
- REPLACE EXISTING 50KVA TRANSFORMER WITH NEW 50KVA, 480/240/120 VOLT, SINGLE PHASE TRANSFORMER. SEE MOUNTING DETAIL ON SHEET E21.
- REPLACE EXISTING 60-AMP FUSED DISCONNECT SWITCH WITH A NEMA 4X, STAINLESS STEEL, 480-VOLT, 200-AMP FUSED DISCONNECT SWITCH. FUSE AT 150-AMPS. SEE ONE-LINE.
- NOT USED.

SPECIFIC NOTES (EAST LAKE-END MACHINERY ROOM POWER):

- NOT USED.
- REPLACE EXISTING PANEL "12N" WITH NEW MINI-POWER ZONE "LI-12N" (AS SCHEDULED). ROUTE SURFACE CONDUIT AND CONDUCTORS TO "LI-12N" AS INDICATED ON THE ONE-LINE. RECONNECT EXISTING CIRCUITS AND PROVIDE NEW BRANCH CIRCUIT WIRING AND CONDUIT TO LOWER ELEVATION MACHINERY ROOM LIGHTS AND RECEPTACLES AS INDICATED ON THE MACHINERY ROOM PLANS.
- NOT USED.
- EXISTING PANEL "1DC" PANEL USED TO FEED LOW-VOLTAGE PANELS AND SITE LIGHTING ON THE EAST SIDE. PLACE BLANK COVER OVER EXISTING PANEL AND ABANDON IN PLACE ONCE EXISTING LOADS ARE RE-SERVED.
- REPLACE EXISTING TROUGH DOWN STAIRS AND ALONG WALL WITH CONDUITS AS NECESSARY TO RE-FEED GATE MOTOR AND PANEL "LL-12N" LOADS. SEE ONE-LINE.
- PROVIDE 200-AMP, NON-FUSED, NEMA 4X STAINLESS STEEL DISCONNECT SWITCH FOR GATE MOTOR.
- NOT USED.
- ONCE NEW SUMP PUMP IS INSTALLED, REMOVE EXISTING TRANSFORMER FEEDING TEMPORARY SUMP PUMP.
- NOT USED.

SPECIFIC NOTES (WEST RIVER-END MACHINERY ROOM POWER):

- NOT USED.
- REMOVE EXISTING TRANSFORMER AND DISCONNECT SWITCH. RECONNECT TRANSFORMER SECONDARY CIRCUITS TO NEW PANEL "LD-SW" TO FEED THE SOUTH OPERATOR SHACK.
- REMOVE EXISTING TRANSFORMER AND DISCONNECT SWITCH AND REPLACE WITH NEW STAINLESS STEEL FUSED DISCONNECT AND STAINLESS STEEL TRANSFORMER. RECONNECT TO EXISTING FEED FOR THE SOUTH CONTROL HOUSE. SEE ONE-LINE.
- REMOVE EXISTING 200-AMP DISCONNECT SWITCH AND ALL ASSOCIATED CONDUIT AND CONDUCTORS FOR "CAPSTAN".
- NOT USED.

SPECIFIC NOTES (EAST RIVER-END MACHINERY ROOM POWER):

- NOT USED.
- REPLACE EXISTING 200-AMP, 3-POLE DISCONNECT SWITCH WITH A 200-AMP, 3-POLE, NEMA 4X, STAINLESS STEEL DISCONNECT SWITCH. PROVIDE NEW CONDUIT AND CONDUITS TO SWITCH AS INDICATED ON THE ONE-LINE. RECONNECT TO THE EXISTING DRAW BRIDGE FEEDER. REPLACE EXISTING DRAW BRIDGE HOUSE MAIN DISCONNECT WITH A MANUAL TRANSFER SWITCH AS INDICATED ON THE REVISED ONE-LINE.



Table with columns: NO., DATE, DESCRIPTION, REVISION, DATE, REVISION, MARK.

U. S. ARMY ENGINEER DISTRICT, NEW ORLEANS CORPS OF ENGINEERS NEW ORLEANS, LOUISIANA

INNER HARBOR NAVIGATION CANAL ORLEANS PARISH, LA IHNC SITE MACHINERY ROOM SPECIFIC NOTES

FILE NUMBER E4 DWG. 6 OF 35

This drawing has been reduced to half size

2006 IMC CONSULTING ENGINEERS INC 3120 20th STREET METAIRIE, LOUISIANA 70002




2

3

4

5

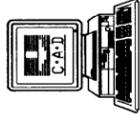




MARK	DESCRIPTION	DATE	APPR.	MARK

DESIGNED BY: PSY	DATE: 02-17-06
CHECKED BY: KML	SCALE: 1/2
DRAWN BY: KML	PLOT DATE: 02-17-06
PROJECT NO.: W912PB-06-B-0034	SUBMITTED BY: PAUL WLOSICH
DESIGN FILE NAME: J:\1404A\ELEC\ES	DESIGN ENGINEER
U. S. ARMY ENGINEER DISTRICT, NEW ORLEANS CORPS OF ENGINEERS NEW ORLEANS, LOUISIANA	

INNER HARBOR NAVIGATION CANAL  
NEW ORLEANS PARISH, LA.  
IHNC  
WEST LAKE-END MACHINERY ROOM  
LIGHTING PLAN

FILE NUMBER  
E5  
DWG. 7 OF 35

© 2006 IMC  
CONSULTING ENGINEERS  
3120 20th STREET  
METairie, LOUISIANA 70002

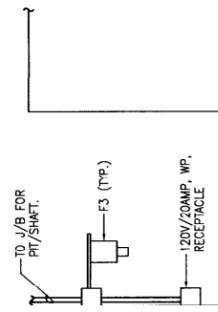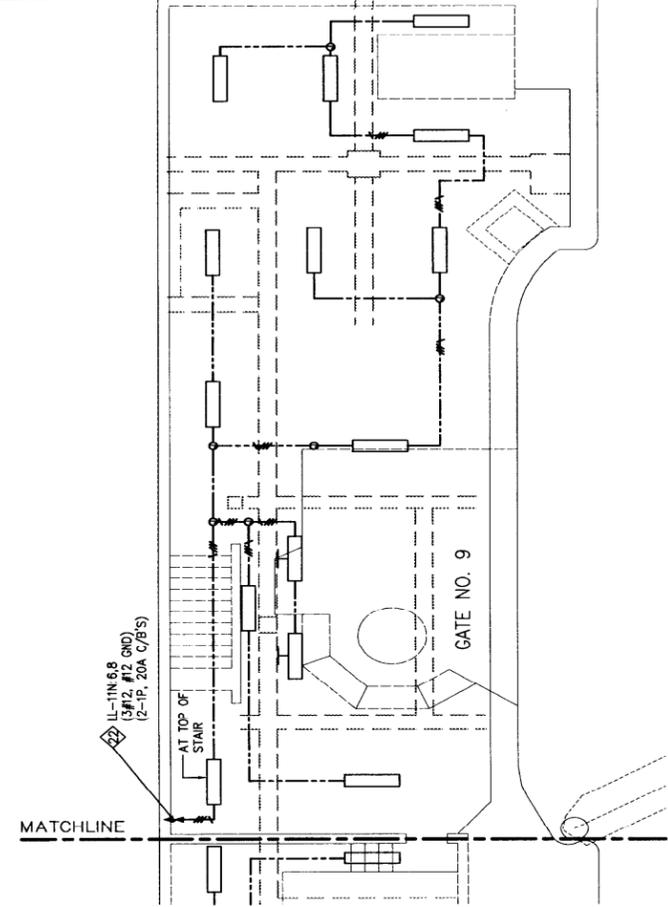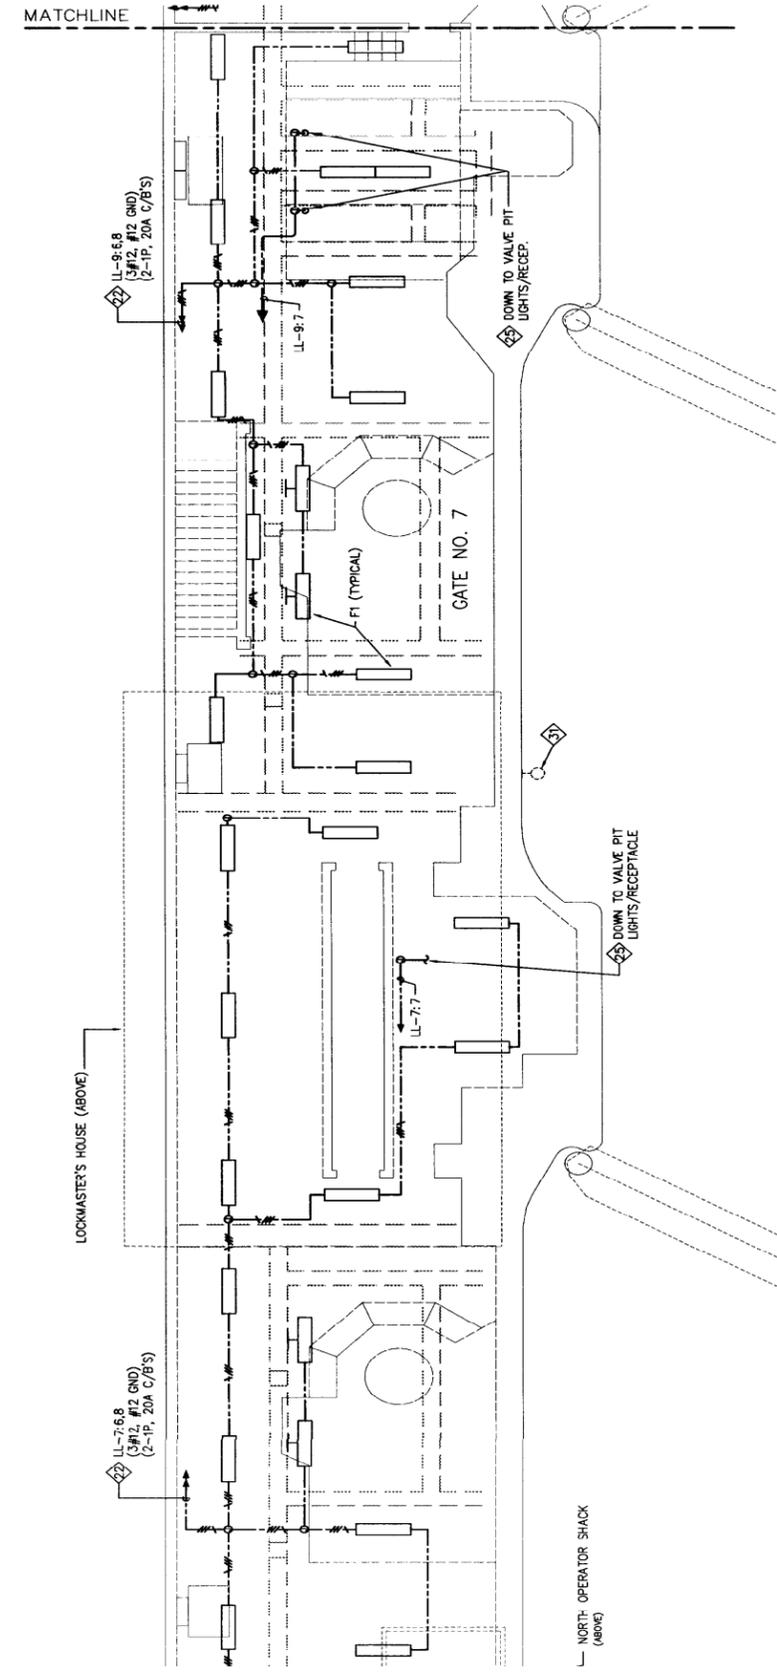


NOTE  
COORDINATE MOUNTING LOCATIONS  
W/OWNER IN FIELD.

**SHAFT LIGHTING DETAIL**

∴ NONE

SEE SHEET E4 FOR  
SPECIFIC NOTES

**1 IHNC WEST LAKE-END MACHINERY ROOM - LIGHTING PLAN**

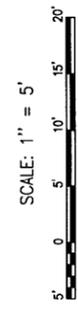

The drawing has been  
reduced to half size

2

3

4

5


2

3


4

5

Safety is a Part  
of Your Contract

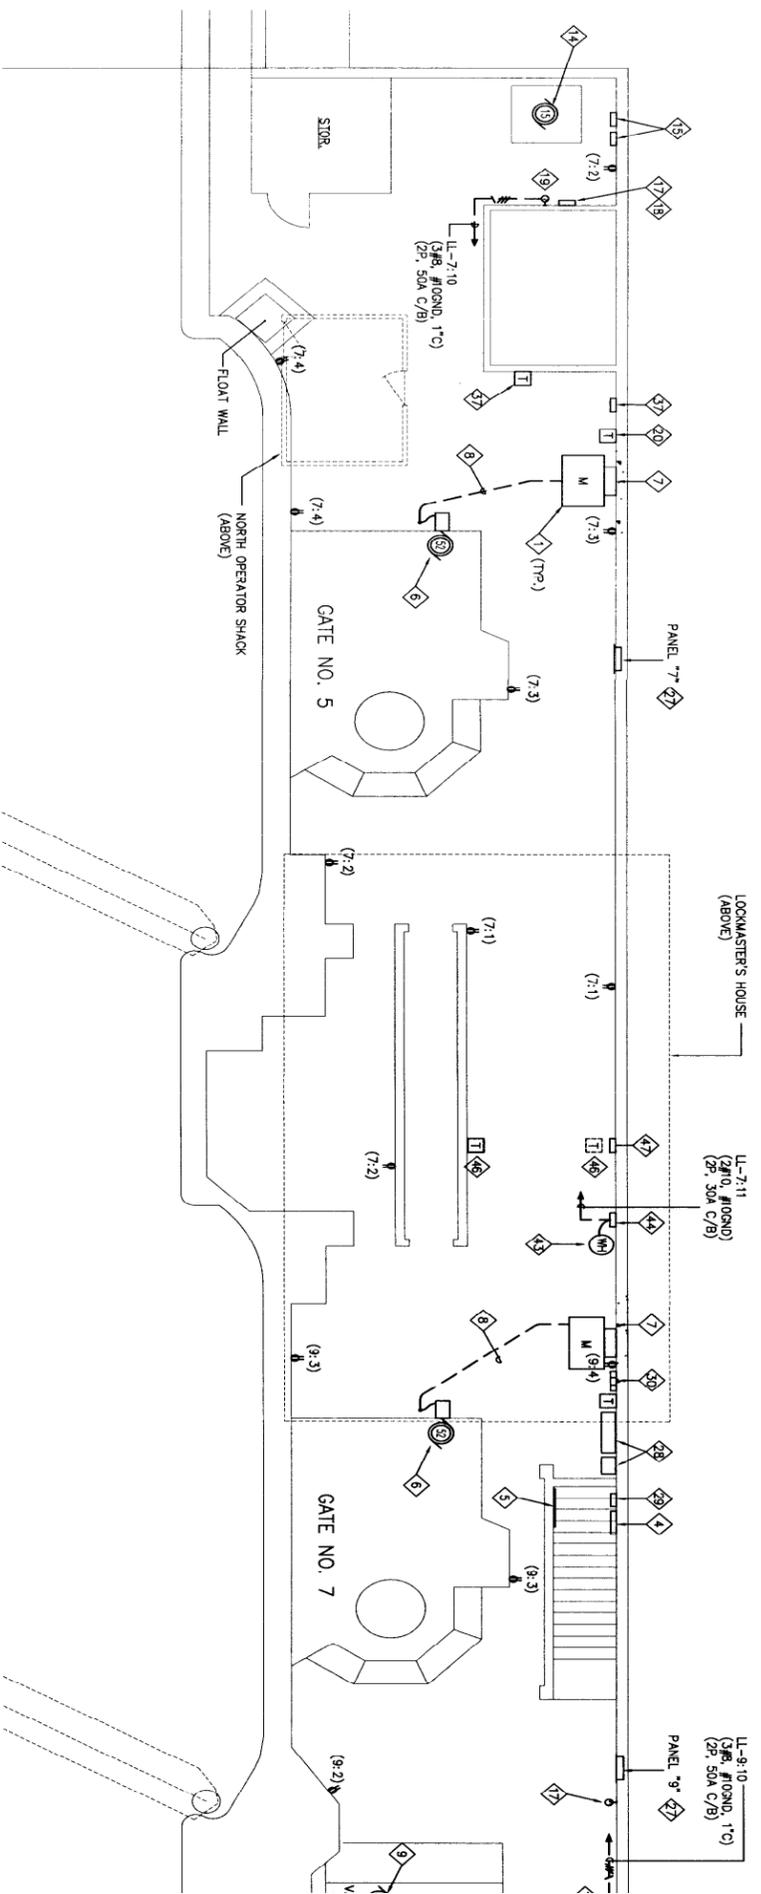


SEE SHEET E4 FOR  
SPECIFIC NOTES

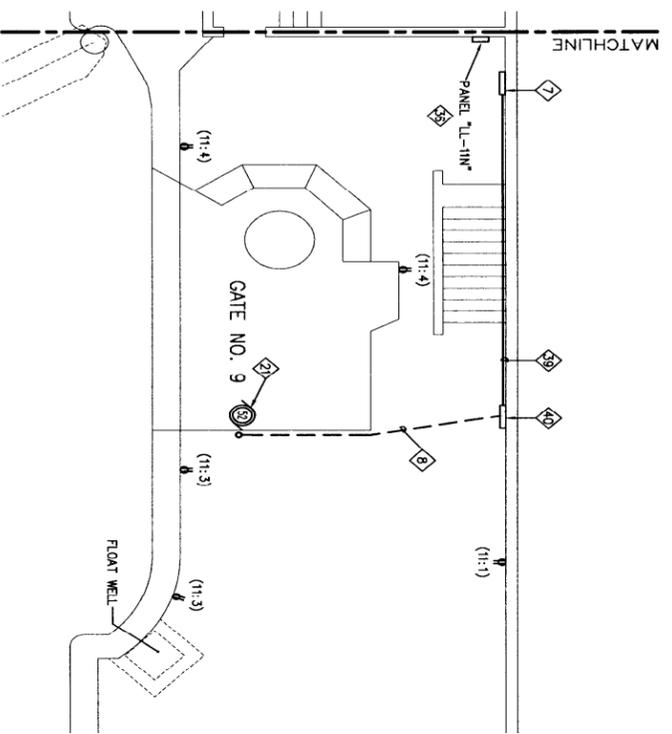


1 IHNC WEST LAKE-END MACHINERY ROOM - POWER PLAN

SCALE: 1" = 5'

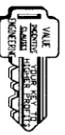


This drawing has been  
reduced to half size


Safety is a Part  
of Your Contract

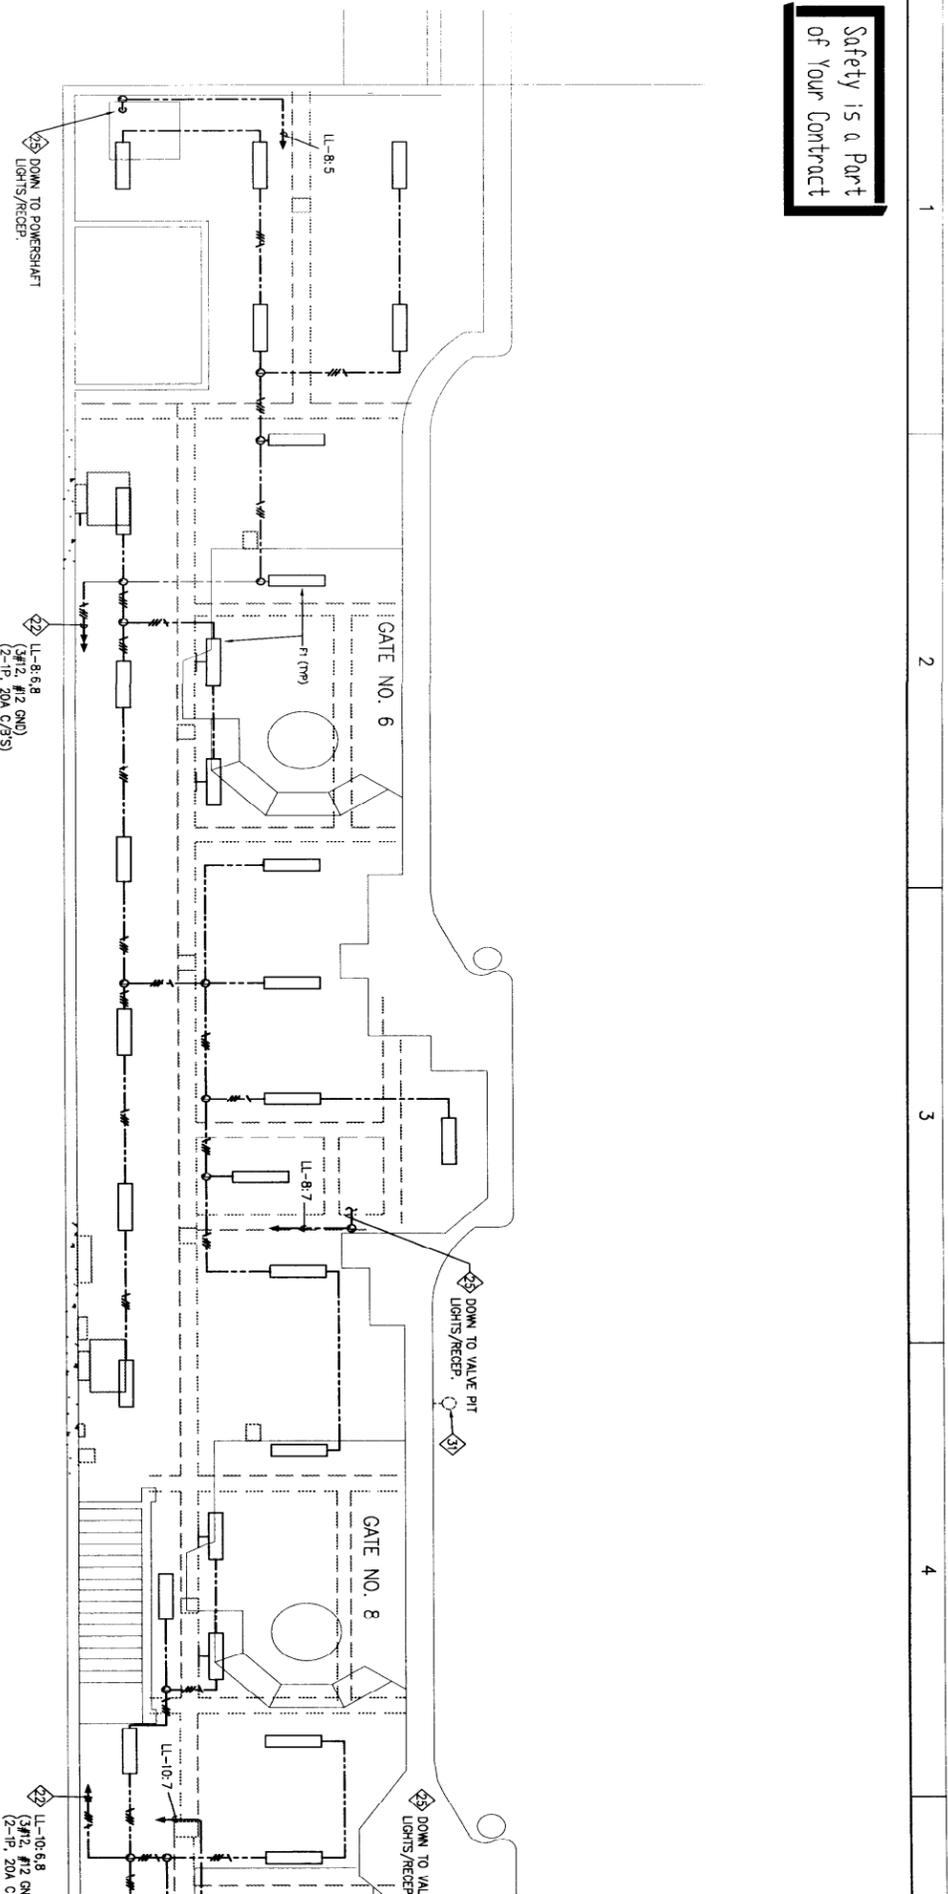

SEE SHEET E4 FOR  
SPECIFIC NOTES

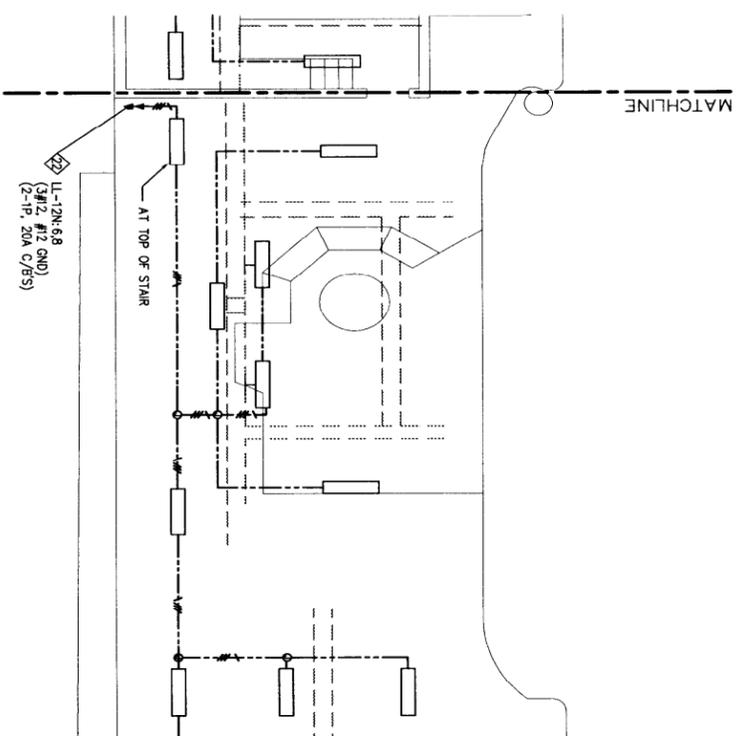


1 IHNC EAST LAKE-END MACHINERY ROOM - LIGHTING PLAN

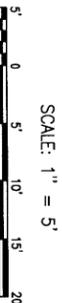


This drawing has been  
reduced to half size

Safety is a Part  
of Your Contract

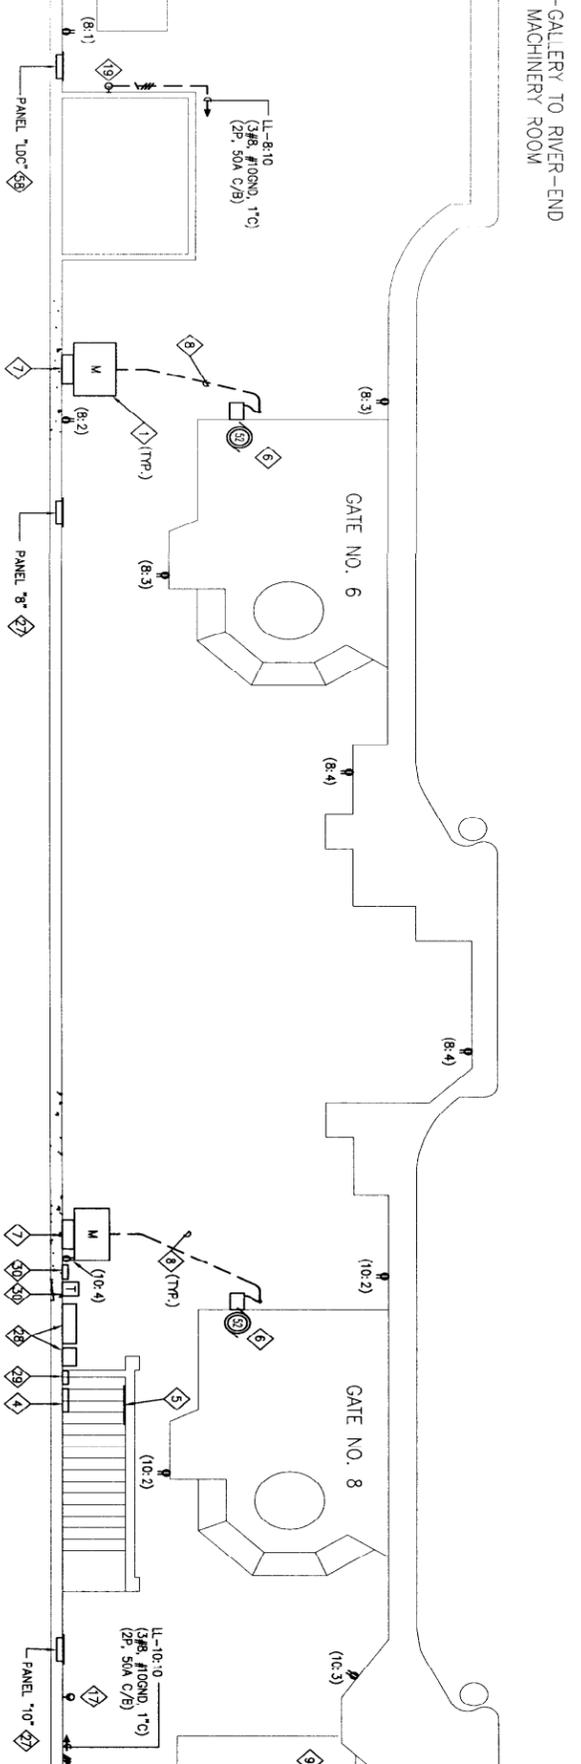

SEE SHEET E4 FOR  
SPECIFIC NOTES

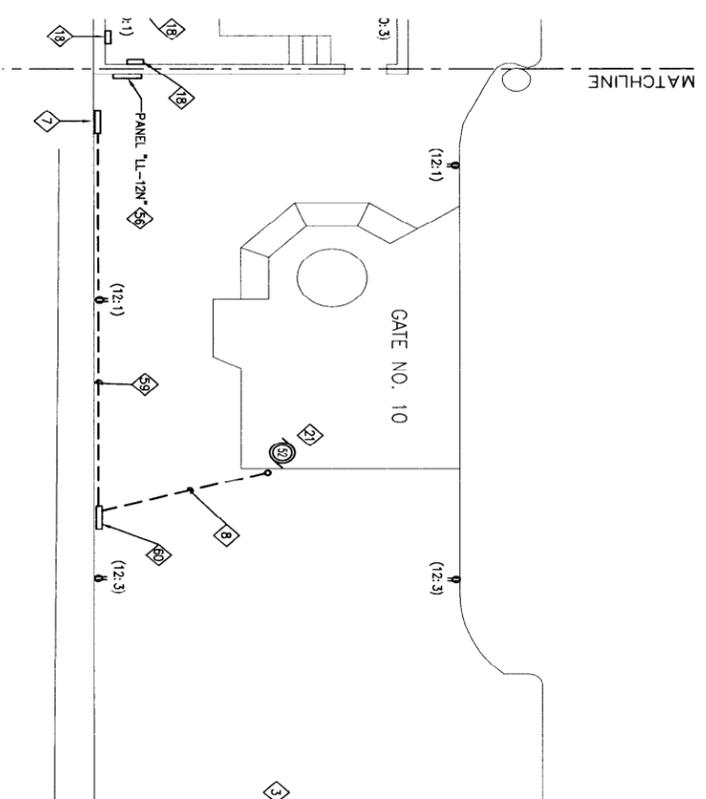


1 IHNC EAST LAKE-END MACHINERY ROOM - POWER PLAN



This drawing has been  
reduced to half size

Safety is a Part  
of Your Contract

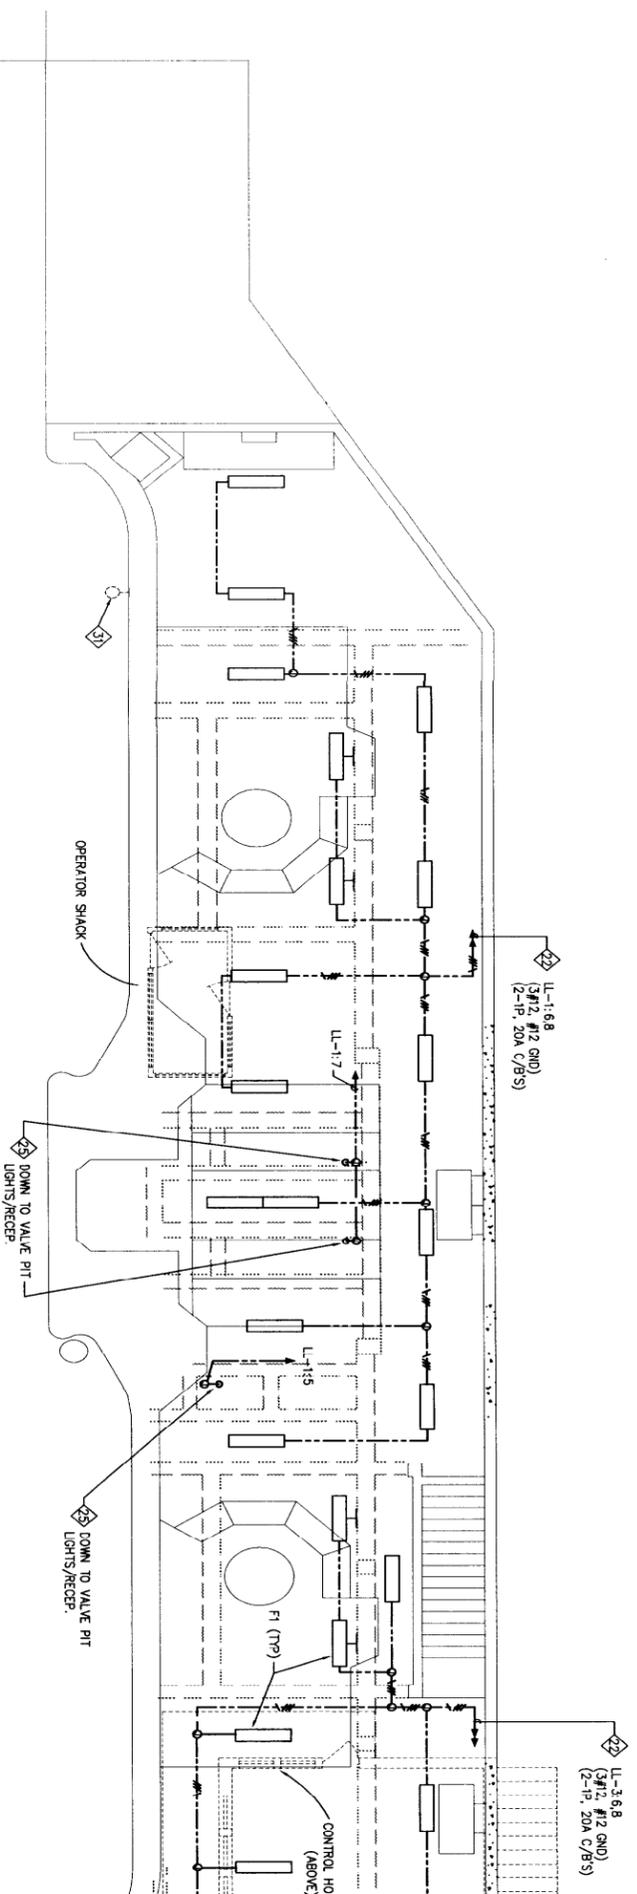


1 IHNC WEST RIVER-END MACHINERY ROOM - LIGHTING PLAN



SCALE: 1" = 5'


SEE SHEET  
SPECIFIC

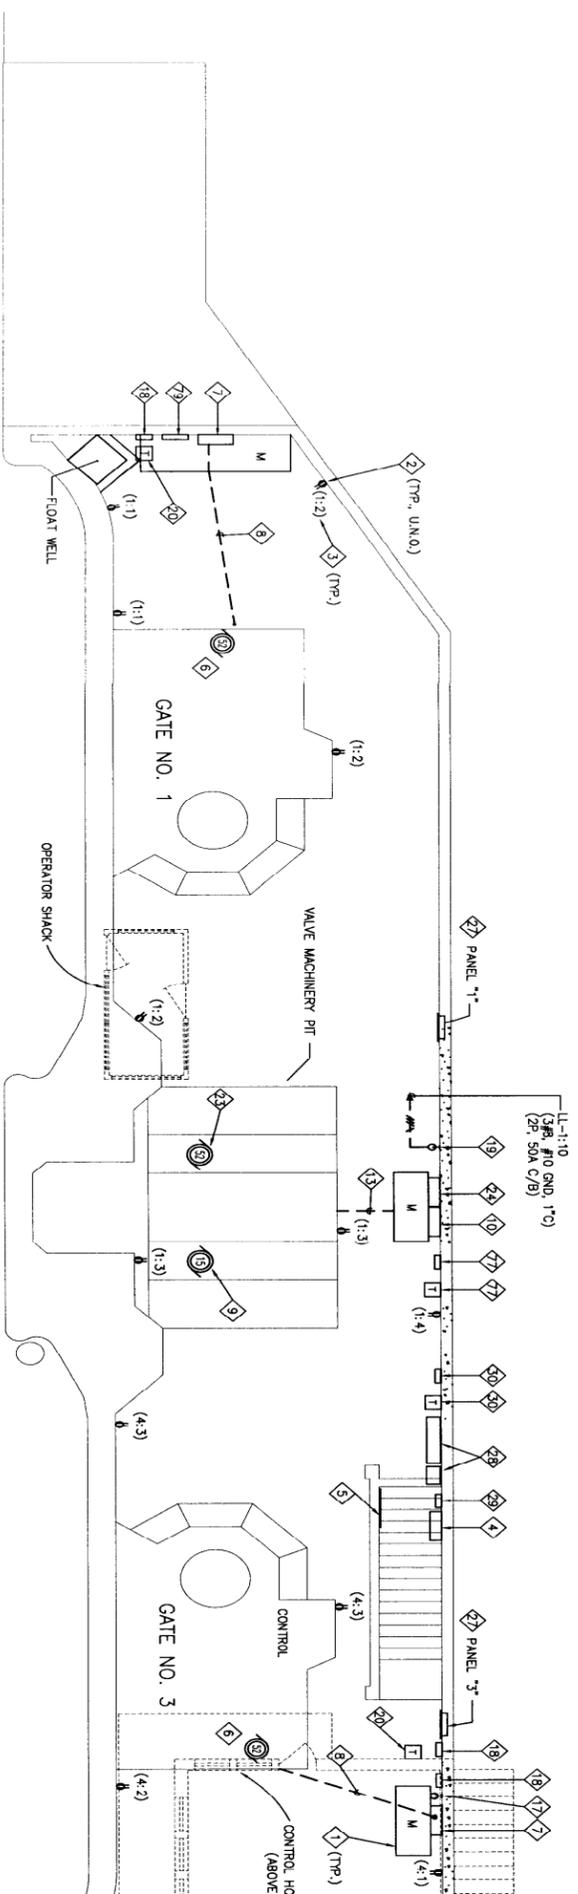

2 IHNC WEST RIVER-END MACHINERY ROOM - POWER PLAN




SCALE: 1" = 5'

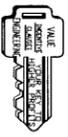

This drawing has been  
reduced to half size


Safety is a Part  
of Your Contract

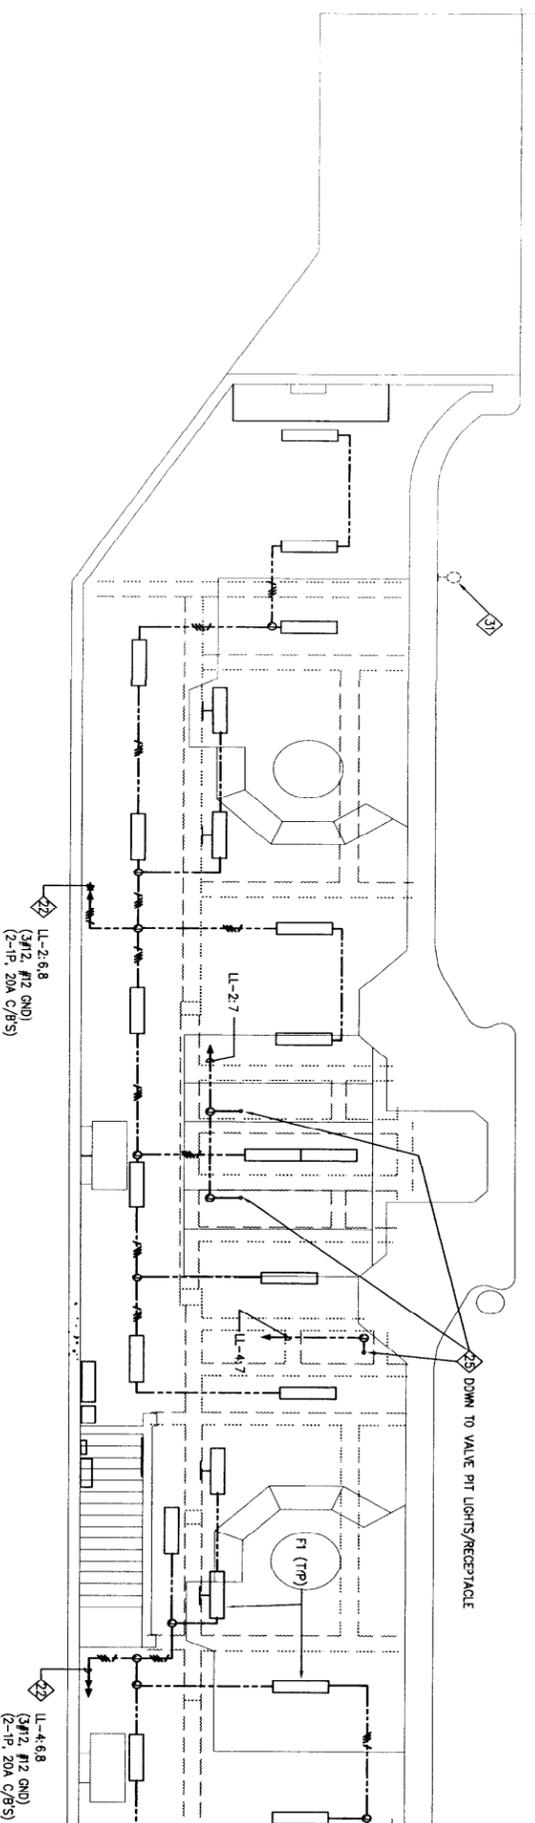


1 IHNC EAST RIVER-END MACHINERY ROOM - LIGHTING PLAN




SEE SHEET  
SPECIFIC

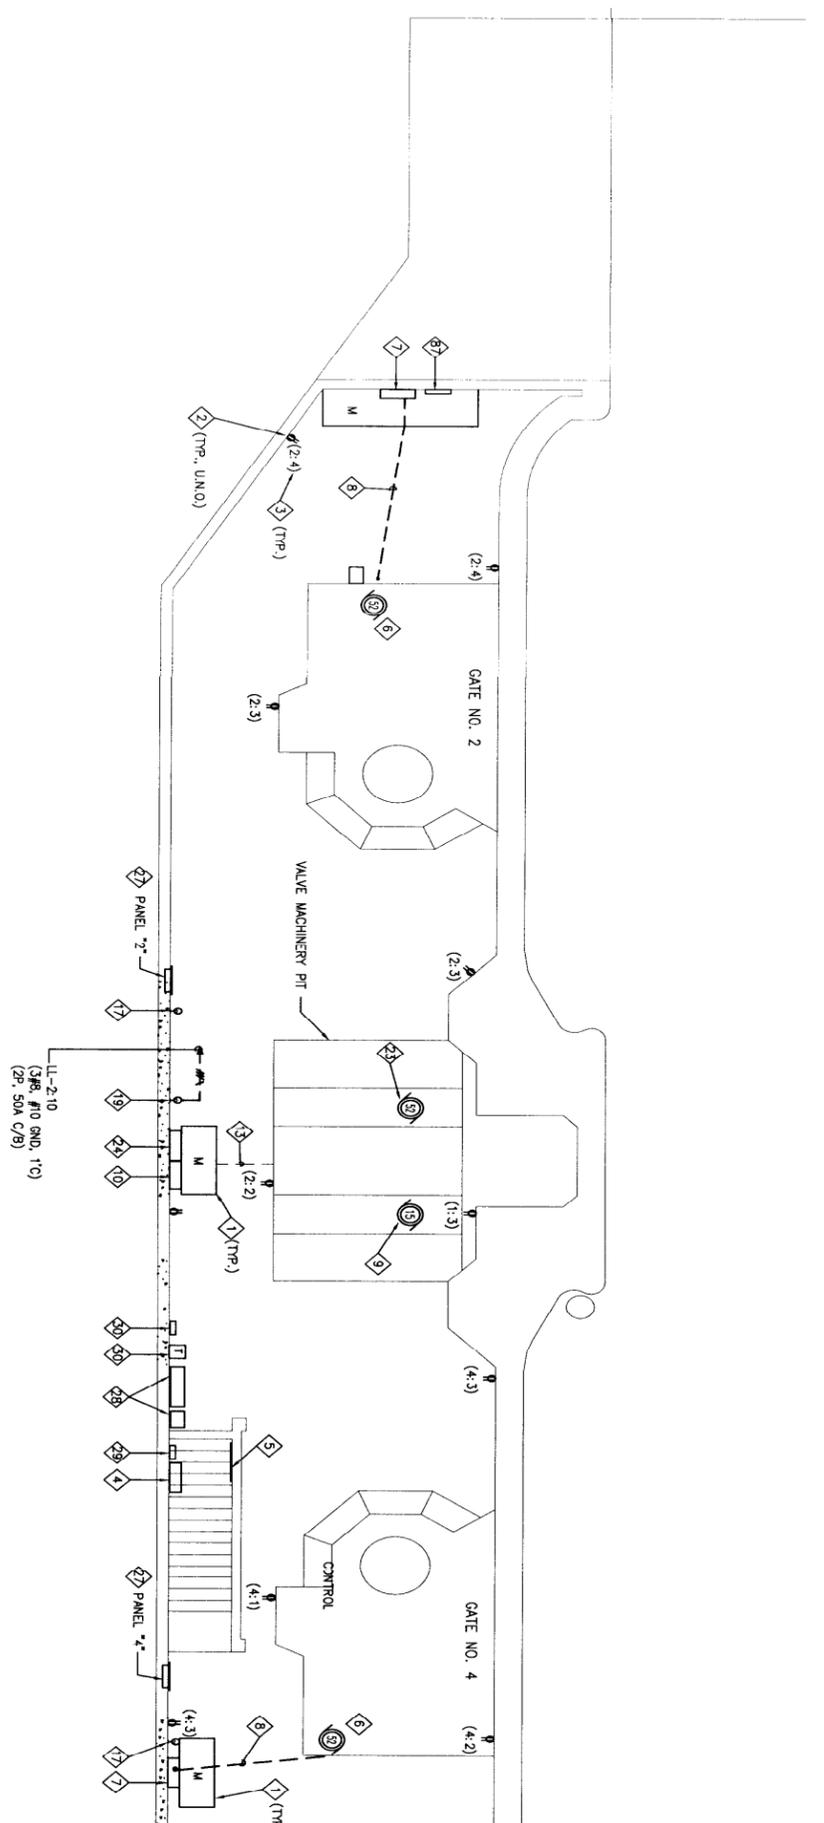


2 IHNC EAST RIVER-END MACHINERY ROOM - POWER PLAN

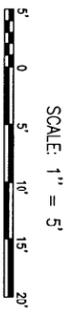


This drawing has been  
reduced to half size

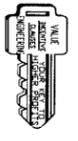



Safety is a Part  
of Your Contract

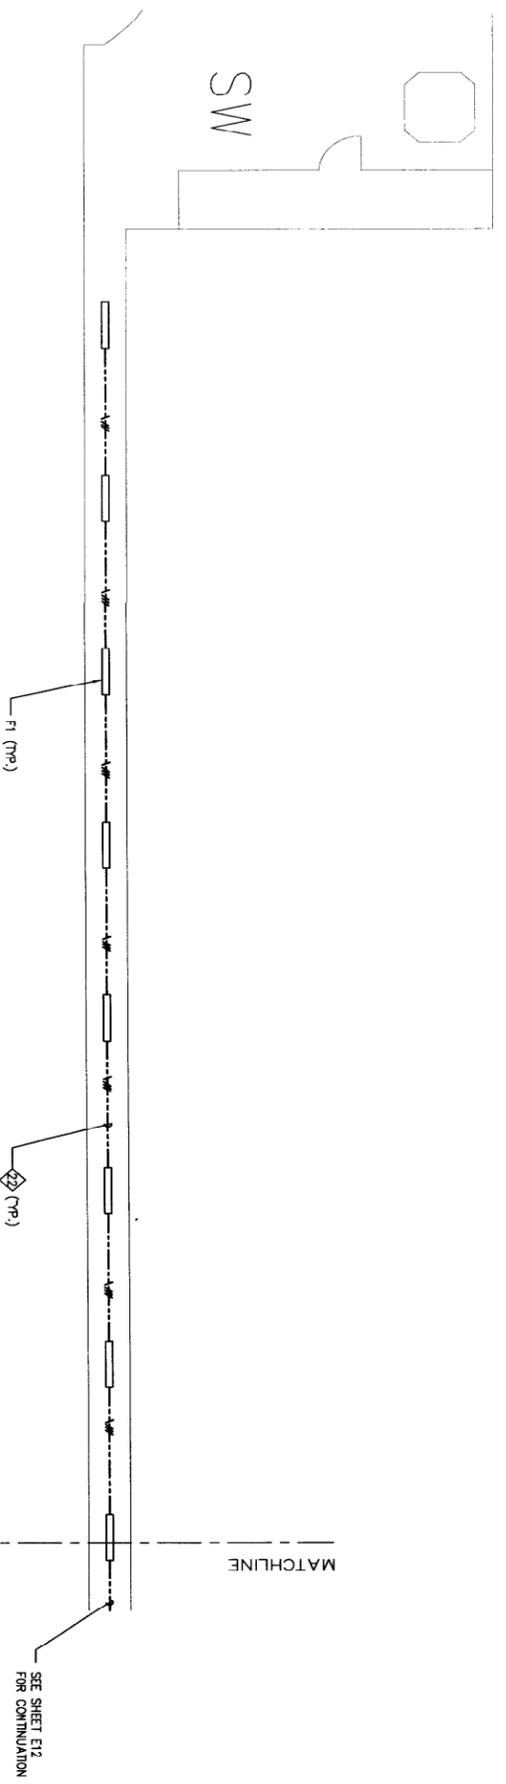

SEE SHEET E4 FOR  
SPECIFIC NOTES

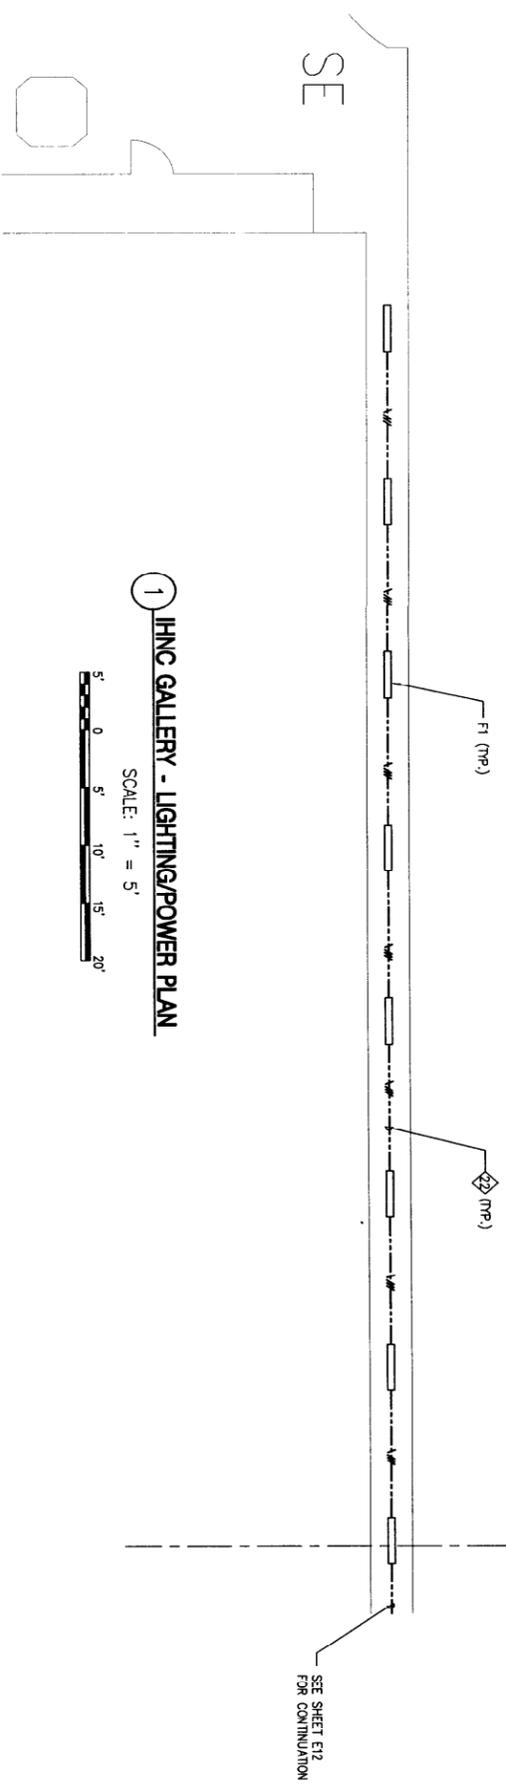

1 IHNC GALLERY - LIGHTING/POWER PLAN

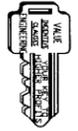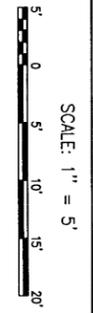


This drawing has been  
reduced to half size

Safety is a Part  
of Your Contract

MATCHLINE

SEE SHEET E11  
FOR CONTINUATION


F1 (TRP)

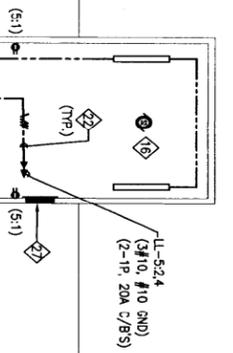

SEE SHEET E4 FOR  
SPECIFIC NOTES

SEE SHEET E11  
FOR CONTINUATION

F1 (TRP)

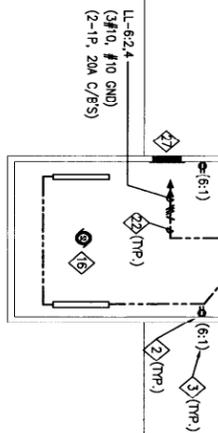

1 IHNC GALLERY - LIGHTING/POWER PLAN

SCALE: 1" = 5'



This drawing has been  
reduced to half size

Safety is a Part  
of Your Contract

1 2 3 4

MATCHLINE

SEE SHEET E12  
FOR CONTINUATION

F1 (TR)

F1 (TR)

SEE SHEET E4 FOR  
SPECIFIC NOTES

SEE SHEET E12  
FOR CONTINUATION

F1 (TR)

F1 (TR)

1 JHNC GALLERY - LIGHTING/POWER PLAN

SCALE: 1" = 5'




1 2 3 4

This drawing has been  
reduced to half size

NI

NI

Safety is a Part  
of Your Contract

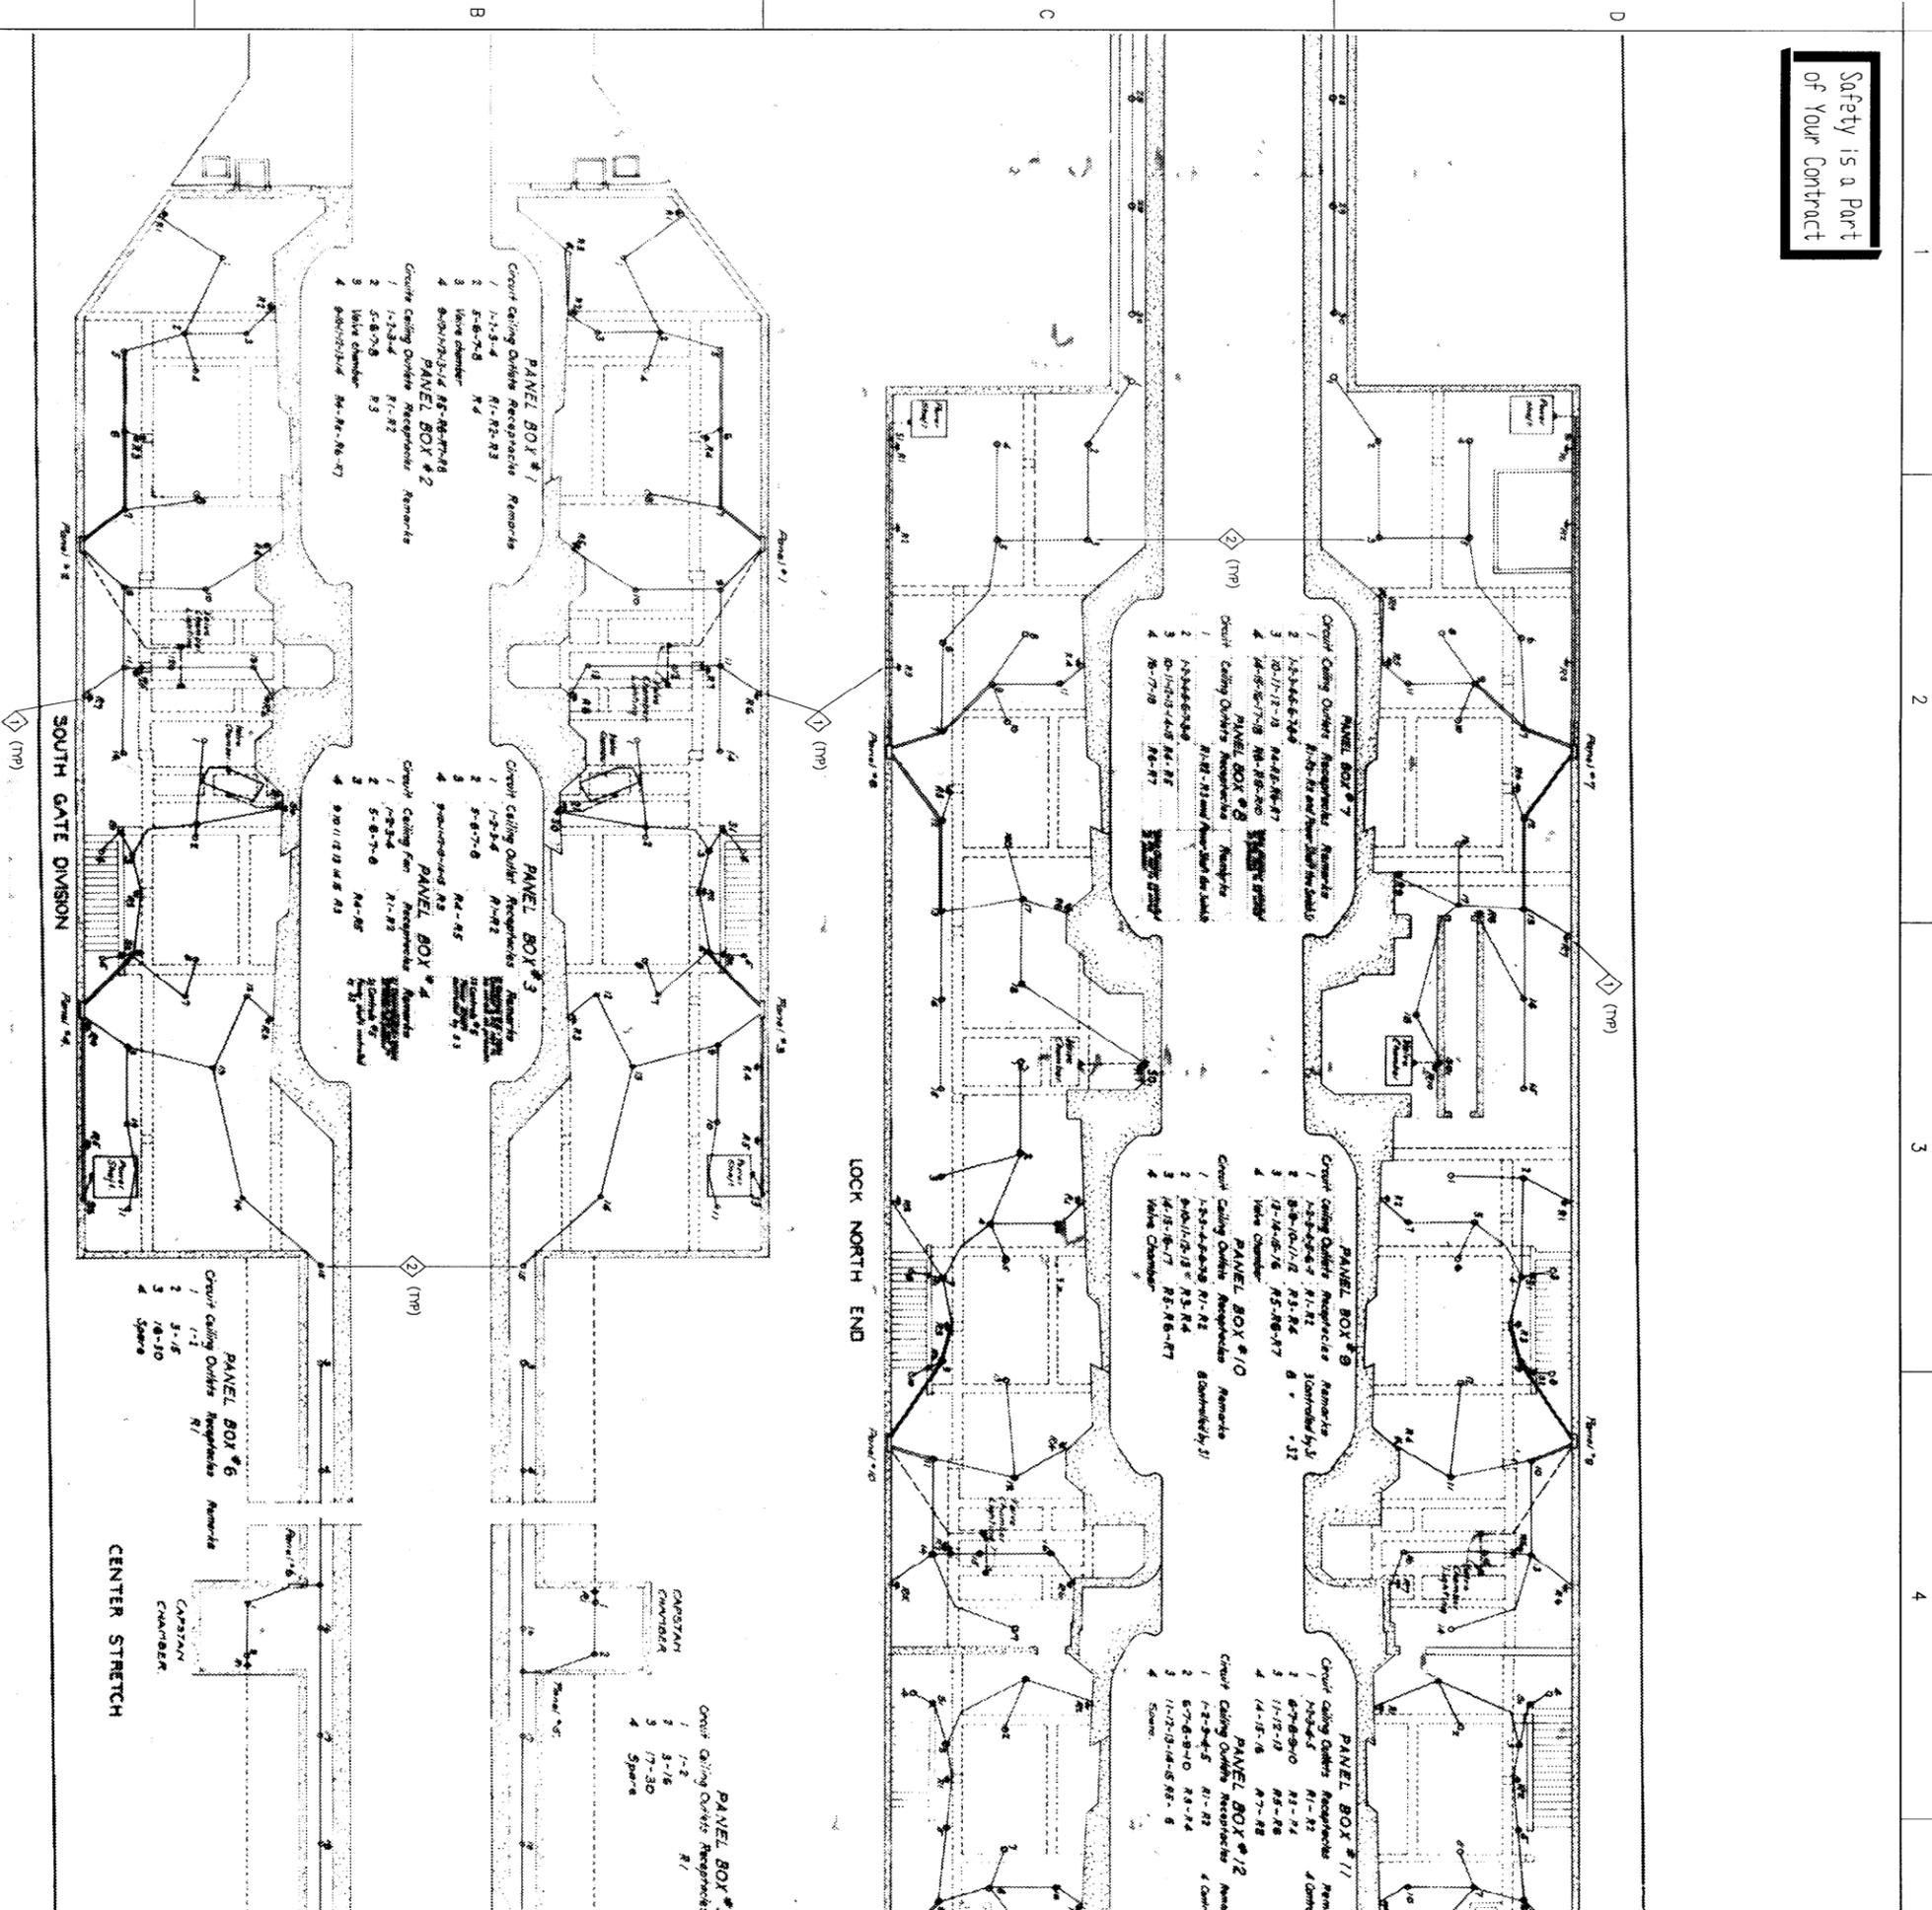

1 EXISTING MACHINERY ROOM - BRANCH CIRCUITS


SCALE: 1/8" = 1'-0"



SPECIFIC NOTES (EXISTING BRAN

- 1 REMOVE EXISTING RECEPTACLE AND ASSOC CONDUCTORS ONCE NEW RECEPTACLES ARE INSTALLED. PROVIDE BLANK COVER PLATE FOR EXISTING RECEPTACLE.
- 2 REMOVE EXISTING LIGHT FIXTURE AND ASSOC CONDUCTORS ONCE NEW FIXTURES ARE INSTALLED. PROVIDE BLANK COVER PLATE FOR EXISTING LIGHT FIXTURE.

This drawing has been reduced to half size

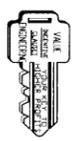


Safety is a Part of Your Contract




661261-7

661261-7

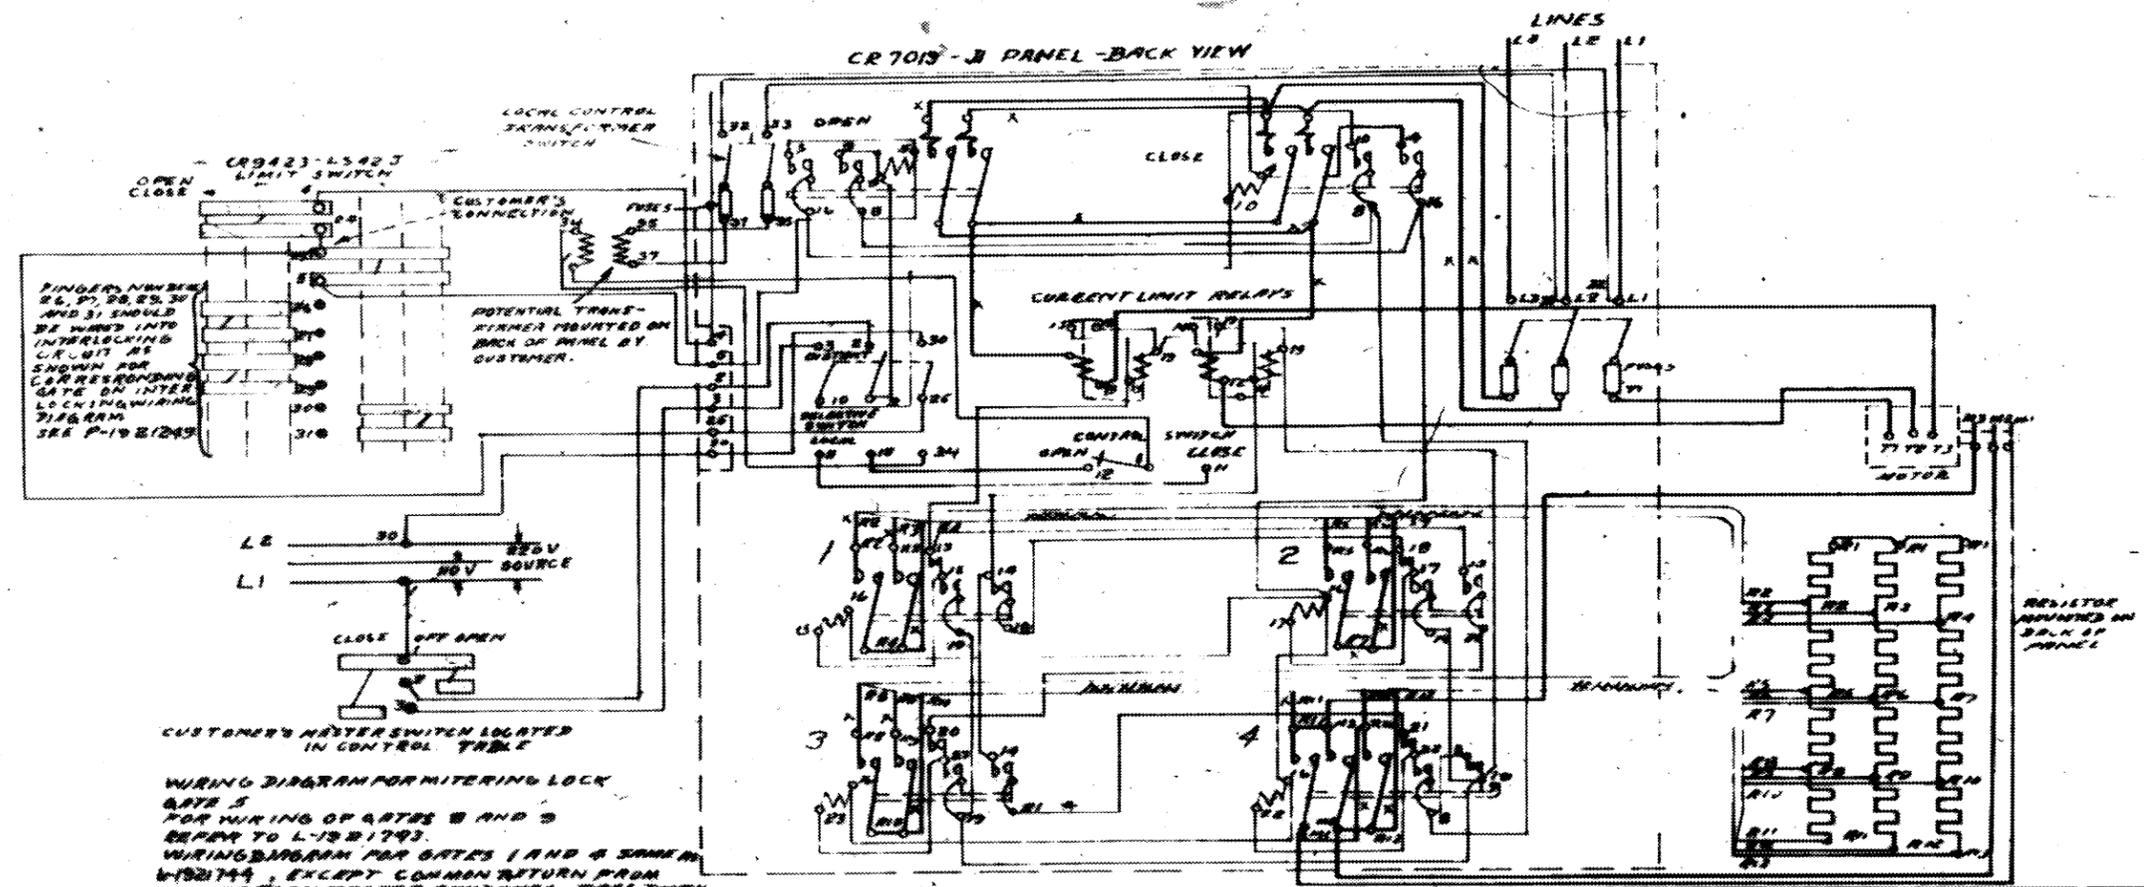

FINGERS NUMBER 26, 27, 28, 29, 30 AND 31 SHOULD BE WIRING INTO INTERLOCKING CIRCUIT AS SHOWN FOR LOCKING DOWN GATE ON INTER LOCKING WIRING DIAGRAM SEE P-1921749

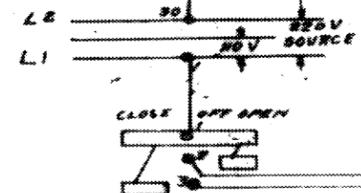

CUSTOMER'S METER SWITCH LOCATED IN CONTROL TABLE

WIRING DIAGRAM FOR MITERING LOCK GATE 5 FOR WIRING OF GATES 8 AND 9 REFER TO L-1921749. WIRING DIAGRAM FOR GATES 1 AND 4 SAME AS L-1921749, EXCEPT COMMON RETURN FROM FINGER 27 ON MASTER SWITCH GONG'S PANEL THRU BASCULE BRIDGE LIMIT SWITCH BEFORE CONNECTING TO 21 225. SEE WIRING DIAGRAM P-1921749 FOR THIS DETAIL. FOR WIRING OF GATES 7 & 10 REFER TO L-1921749

MECHANICAL INTERLOCK BETWEEN CONTRACTORS OPEN AND CLOSE PANEL WIRING PER S.I. 8212 & 50.

NOTICE TO PURCHASER REFER TO CONTRACT FOR MATERIAL TO BE SUPPLIED BY THE GENERAL ELECTRIC CO. THE AMOUNT OF SUCH MATERIAL IS NOT DETERMINED BY ANYTHING SHOWN UPON THIS DRAWING.

①	WIRING	ADDED
②	WIRING	CHANGED
③	WIRING	ADDED
④	WIRING	CHANGED
⑤	WIRING	ADDED
⑥	WIRING	CHANGED
⑦	WIRING	ADDED
⑧	WIRING	CHANGED
⑨	WIRING	ADDED
⑩	WIRING	CHANGED

**CONNECTIONS OF CR 7019-JI PANEL**

FIRST MADE FOR REG A-3300 L-1921744

BEGUN BY LAMERLARR, TRACED BY R. CHITTY, FINISHED BY ENGLISH, INSPECTED BY L. J. ...

GENERAL ELECTRIC CO. SCHEENSTADY, N.Y. L-1921744

EC.

1 ORIGINAL MITRE GATE MOTOR CONTROL DIAGRAM SCALE: NONE (GATES: 1, 4, 5)

This drawing has been reduced to half size

U. S. ARMY ENGINEER DISTRICT, NEW ORLEANS CORPS OF ENGINEERS NEW ORLEANS, LOUISIANA

DESIGNED BY: PSV  
CHECKED BY: KACL  
SCALE: AS SHOWN  
DATE: 02-17-06


DESIGN FILE NAME: 17044-EE-05  
SOLUTION NO: W61278-06-B-0034  
DATE: 02-17-06  
DRAWN BY: ...  
DATE: 02-17-06

INNER HARBOR NAVIGATION CANAL ORLEANS PARISH, LA. ORIGINAL MITRE GATE MOTOR CONTROL DIAGRAM

Safety is a Part of Your Contract



L-1922260

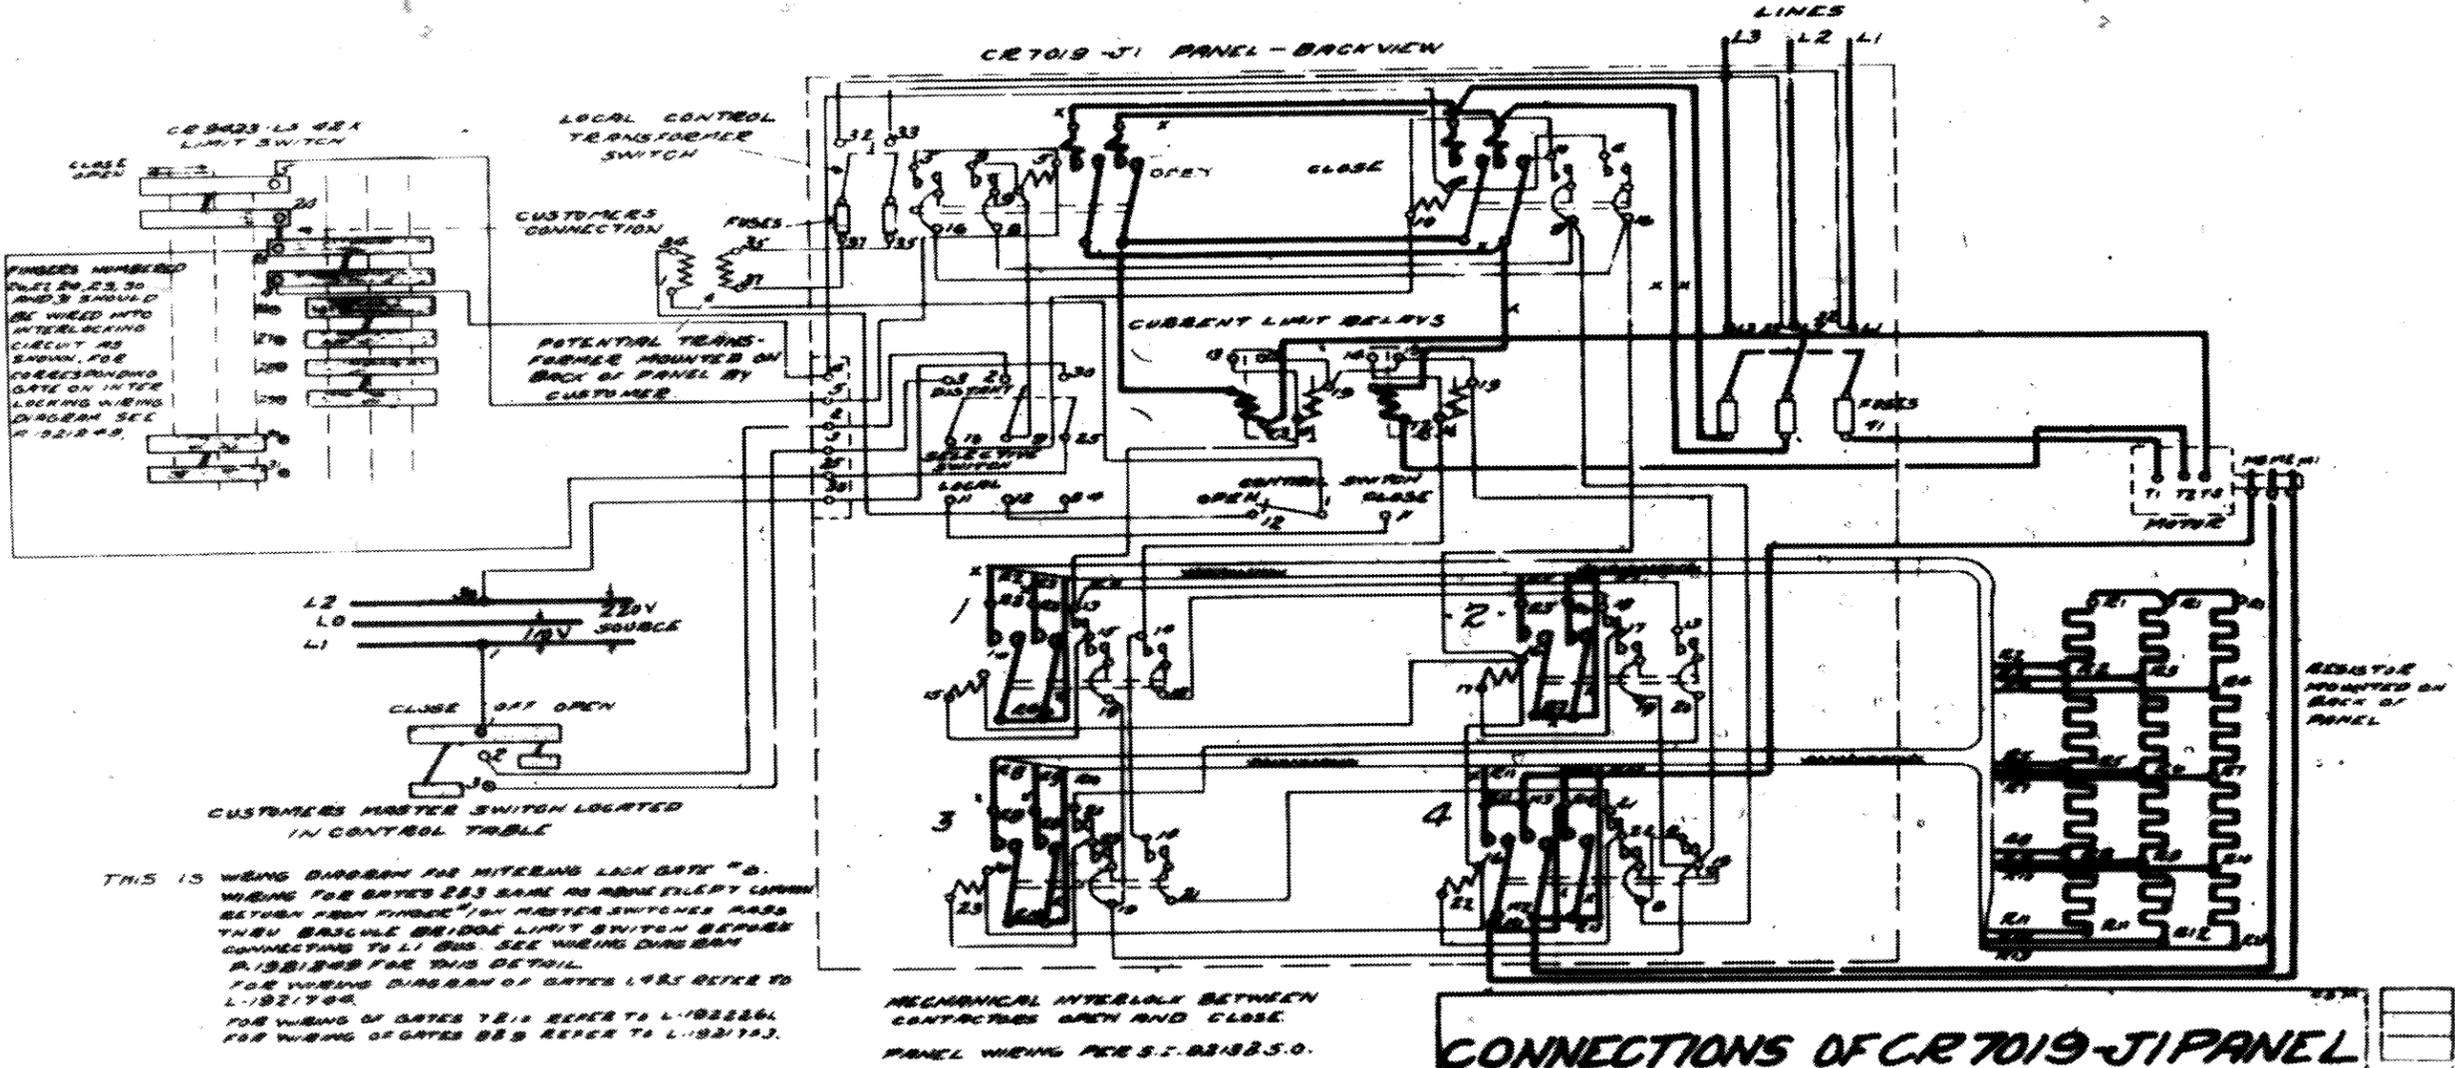

L-1922260

1 ORIGINAL MITRE GATE MOTOR CONTROL DIAGRAM  
SCALE: NONE (GATES: 2, 3, 6)

This drawing has been reduced to half size

IMC CONSULTING ENGINEERS  
3120 20th STREET  
METairie, LOUISIANA 70002

U. S. ARMY ENGINEER DISTRICT, NEW ORLEANS  
CORPS OF ENGINEERS  
NEW ORLEANS, LOUISIANA

DESIGNED BY: PSV  
CHECKED BY: KJH  
DATE: 02-17-06

ISSUED BY: PSV  
DATE: 02-17-06

PROJECT FILE NAME: J740444/ELEC/56  
SUBMITTED BY: OSCH  
DESIGN NUMBER: W9129-06-0-0034

INNER HARBOR NAVIGATION CANAL  
ORLEANS PARISH, LA.

ORIGINAL MITRE GATE  
MOTOR CONTROL DIAGRAM


FILE NUMBER  
E16  
DWG 18 OF 35

Safety is a Part of Your Contract



U.S. Army Corps of Engineers  
New Orleans District

192226

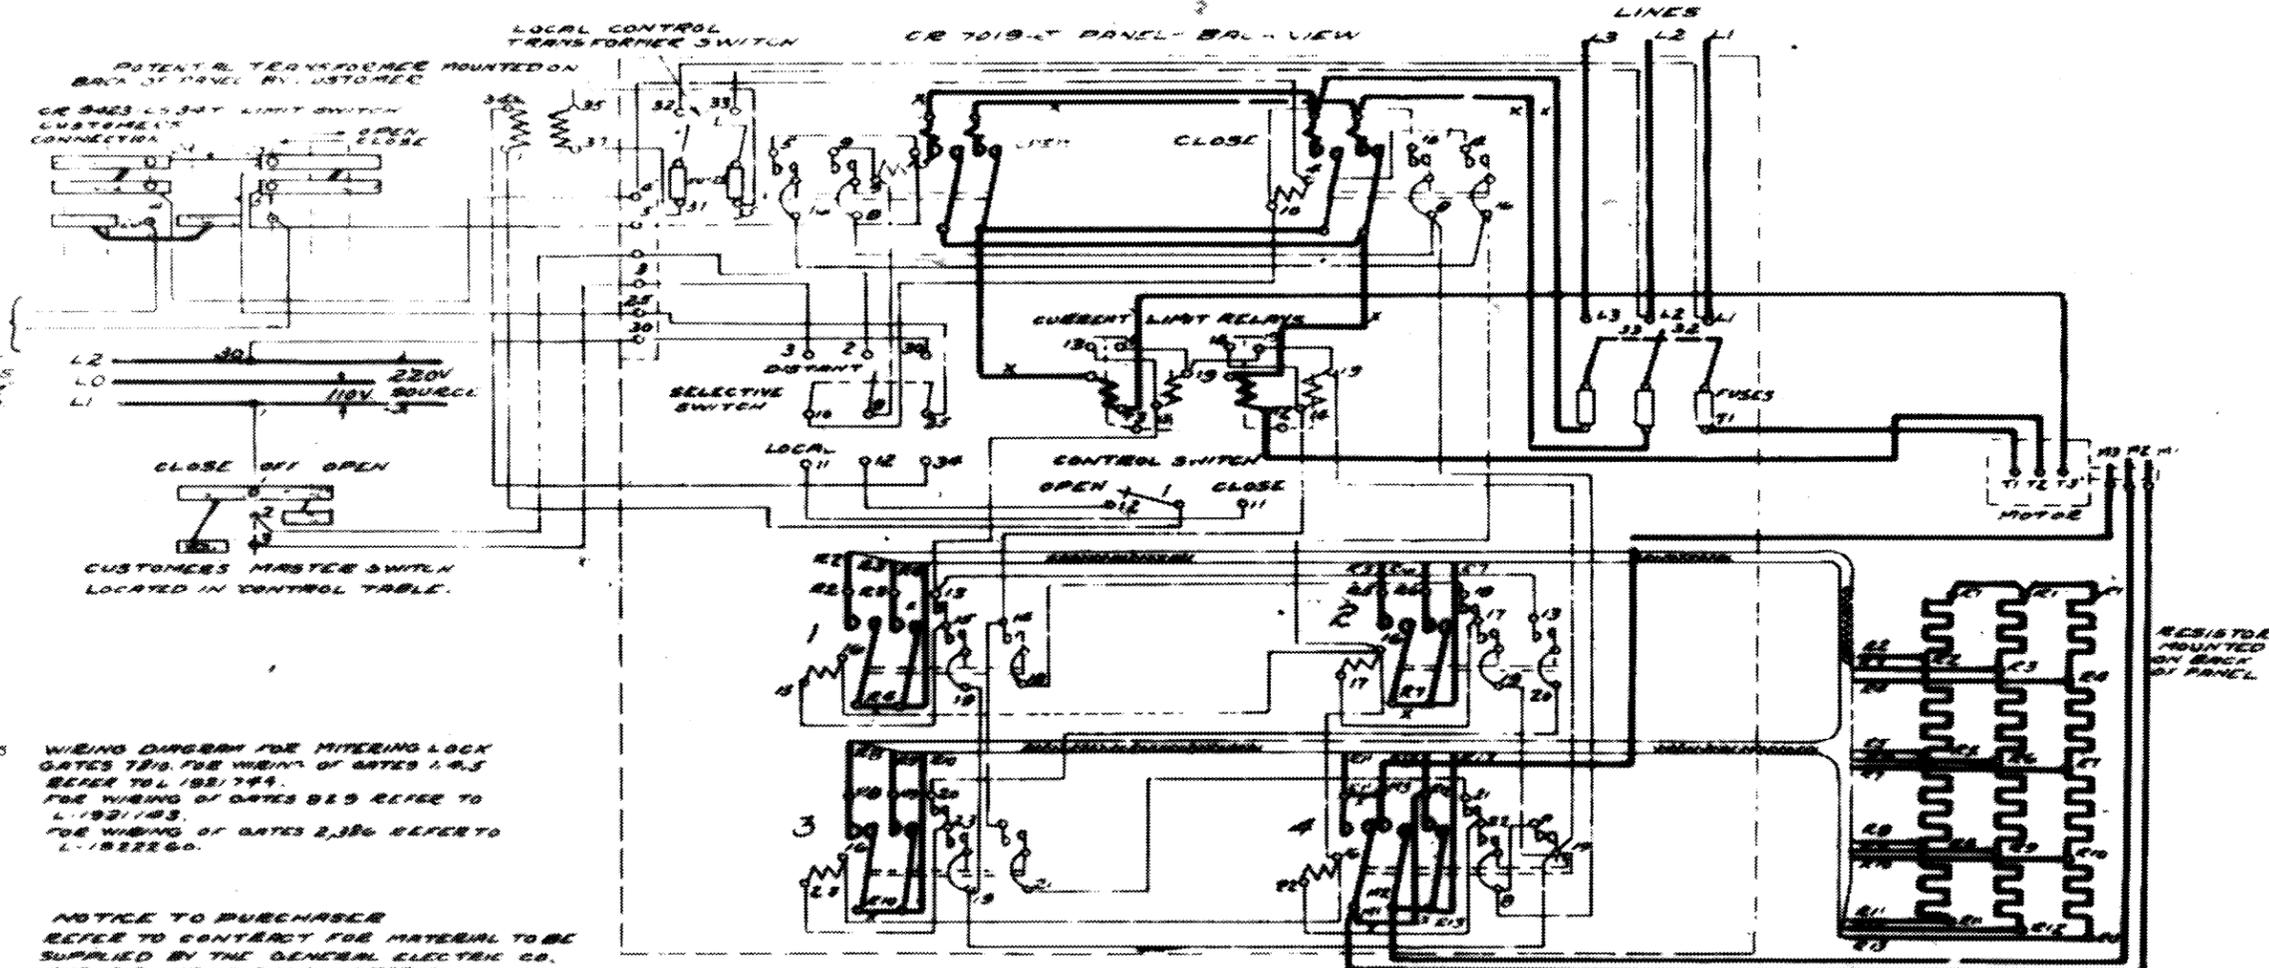

CONNECTED IN INTERLOCKING CIRCUIT TO PREVENT SEMPHORES SHOWING CLEAR AT LOWER END SEE DRAWING P. 1921283

CLOSE OR OPEN CUSTOMER'S MASTER SWITCH LOCATED IN CONTROL TABLE.

THIS IS WIRING DIAGRAM FOR MITRE LOCK GATES 7815 FOR WIRING OF GATES 1, 4, 5 REFER TO L 1921744. FOR WIRING OF GATES 823 REFER TO L 1921743. FOR WIRING OF GATES 2, 3, 6 REFER TO L 1922260.

NOTICE TO PURCHASER REFER TO CONTRACT FOR MATERIAL TO BE SUPPLIED BY THE GENERAL ELECTRIC CO. THE AMOUNT OF SUCH MATERIAL IS NOT INCREASED BY ANYTHING SHOWN UPON THIS DRAWING.

MECHANICAL INTERLOCK BETWEEN CONTACTS OPEN AND CLOSE OF PANEL WIRING PER ST 8875 AND 80.

**CONNECTIONS OF CR 7019-J PANEL**  
FIRST MADE FOR REG. # 33/90 L: 1922261  
BEGUN BY ANNE B. WADSWORTH TRACED BY GARY R. BERRY  
FINISHED BY ALAN L. BERRY INSPECTED BY GARY R. BERRY  
GENERAL ELECTRIC CO. SCENECTADY NY L: 1922261  
1/C



1 ORIGINAL MITRE GATE MOTOR CONTROL DIAGRAM  
SCALE: NONE (GATES: 7, 10)

This drawing has been reduced to half size

© 2006 IMC CONSULTING ENGINEERS INC.  
3120 20th STREET METAIRIE, LOUISIANA 70002

U. S. ARMY ENGINEER DISTRICT, NEW ORLEANS  
CORPS OF ENGINEERS  
NEW ORLEANS, LOUISIANA  
DESIGNED BY: PSV  
CHECKED BY: KML  
DATE: 02-17-05  
PLOT DATE: 02-17-06  
DESIGN FILE NAME: J:\F004\ELECT\ET  
SUBMITTED BY: PAUL VUCOSCH  
DRAWN BY: KML  
DATE: 02-17-05  
SELECTION NO. - W61289-06-B-0034  
JOB NUMBER

INNER HARBOR NAVIGATION CANAL  
ORLEANS PARISH, LA  
ORIGINAL MITRE GATE  
MOTOR CONTROL DIAGRAM

FILE NUMBER  
E17  
DWG. 19 OF 35







Safety is a Part of Your Contract



US Army Corps of Engineers  
New Orleans District

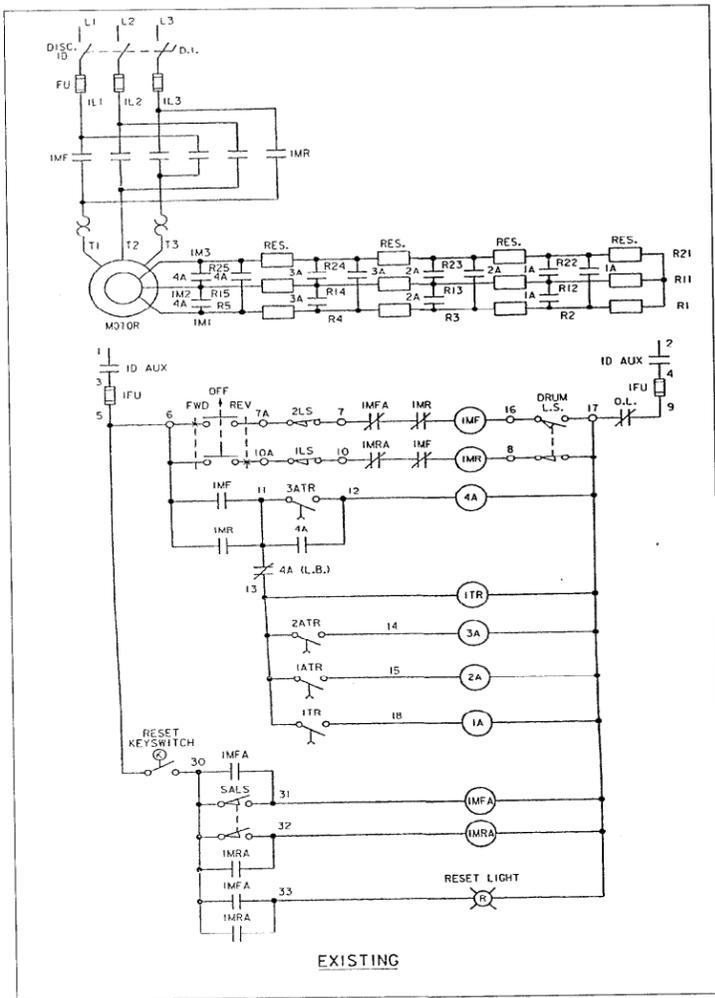

1 MITER GATE MOTOR CONTROL SCHEMATIC  
SCALE: NONE

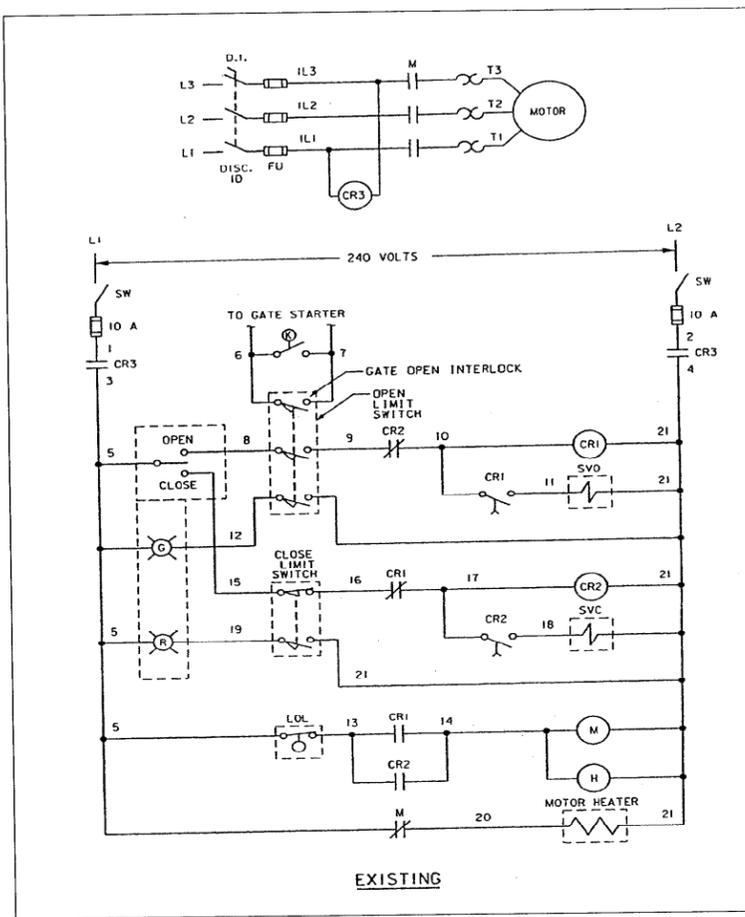

2 HYDRAULIC VALVE MOTOR CONTROL SCHEMATIC  
SCALE: NONE

INFORMATION TAKEN FROM FIELD:

CONTACTOR	CONTACT RATING	COIL RATING	COIL #	CAT # (ALLEN BRADLEY)
1A	45A	220V	AB 72A755	X-247574
2A	45A	220V	AB 72A755	X-247574
3A	45A	220V	AB 72A755	X-247574
4A	?	220V	AB 73A06	X-234075

This drawing has been reduced to half size

© 2006 IMC 1404A  
CONSULTING ENGINEERS  
3120 29th STREET  
METAIRIE, LOUISIANA 70002

U. S. ARMY ENGINEER DISTRICT, NEW ORLEANS  
CORPS OF ENGINEERS  
NEW ORLEANS, LOUISIANA

DESIGNED BY PSV  
CHECKED BY KUH  
DATE 02-17-06

FILE DESIGN FILE NAME: J:\404A\ELC/E20  
DATE: 02-17-06  
SUBMITTED BY: KUH  
DESIGN ENGINEER: WJZ  
ASSOCIATION NO: WJZ206-06-B-0034

INNER HARBOR NAVIGATION CANAL  
ORLEANS PARISH, LA  
EXISTING  
MOTOR CONTROL SCHEMATICS


FILE NUMBER  
E20  
DWG 22 OF 35



Safety is a Part of Your Contract




EXPOSED BUS BARS WEST SIDE - RIVER END MACHINERY ROOM "SW" (SEE EXISTING WEST RIVER-END ONE-LINE)  
 EXPOSED BUS BARS EAST SIDE - RIVER END MACHINERY ROOM "SE" (SEE EXISTING EAST RIVER-END ONE-LINE)  
 EXPOSED BUS BARS WEST SIDE - LAKE END MACHINERY ROOM "NW" (SEE EXISTING WEST LAKE-END ONE-LINE)  
 EXPOSED BUS BARS EAST SIDE - LAKE END MACHINERY ROOM "NE" (SEE EXISTING EAST LAKE-END ONE-LINE)

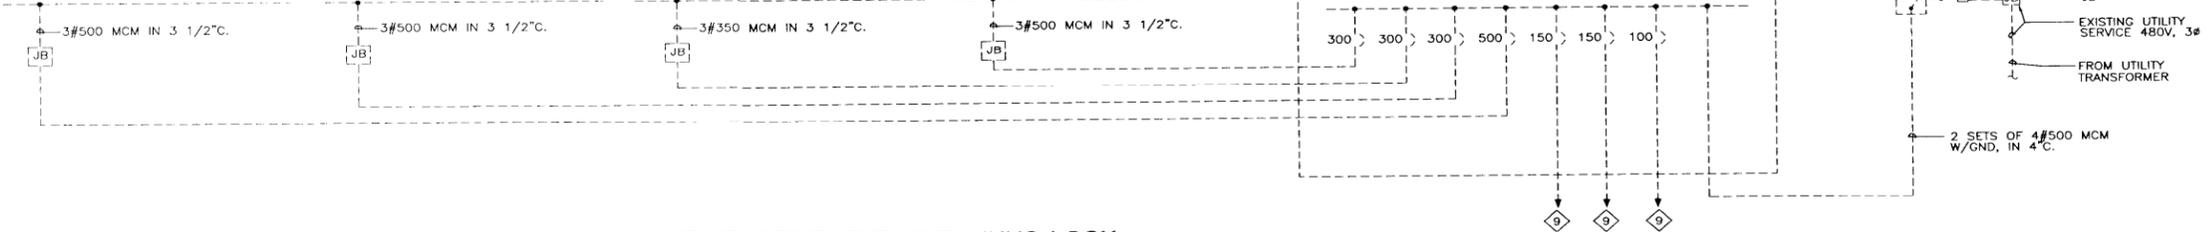


1 EXISTING ONE-LINE - IHNC LOCK  
SCALE: NONE


SEE SHEET E21 FOR SPECIFIC NOTES

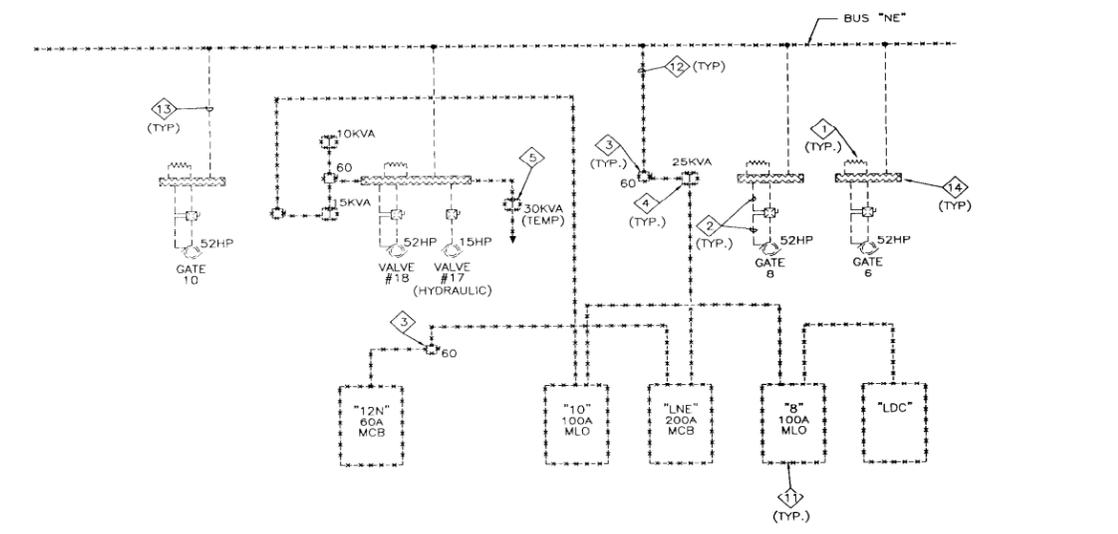


2 EXISTING ONE-LINE (EAST LAKE-END)  
SCALE: NONE

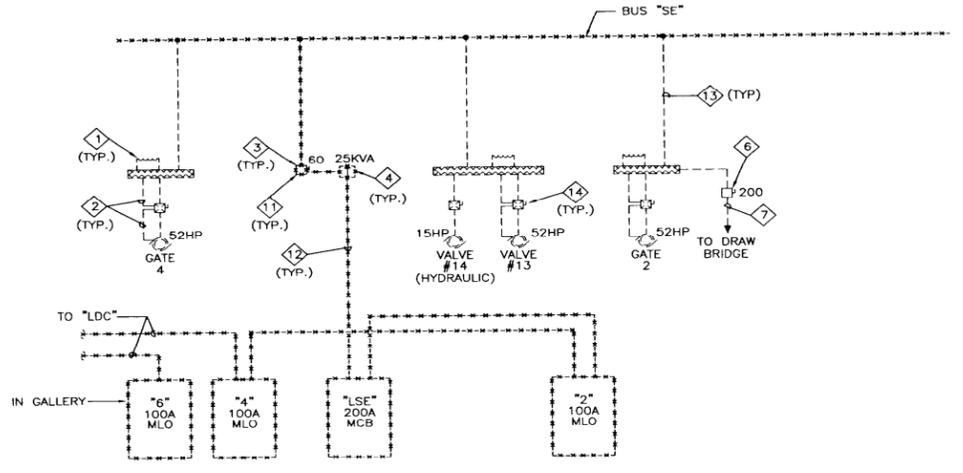

3 EXISTING ONE-LINE (EAST RIVER-END AND GALLERY)  
SCALE: NONE

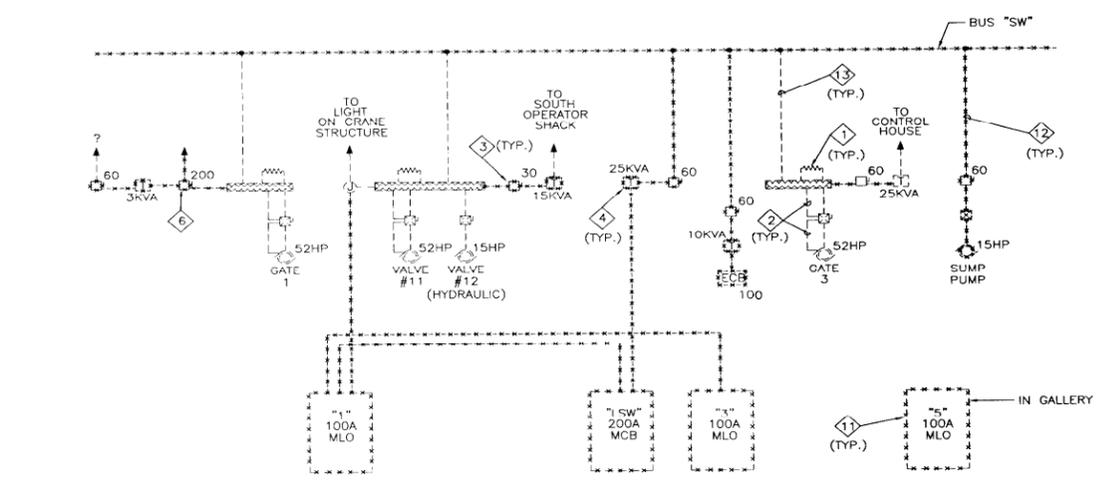

4 EXISTING ONE-LINE (WEST RIVER-END AND GALLERY)  
SCALE: NONE

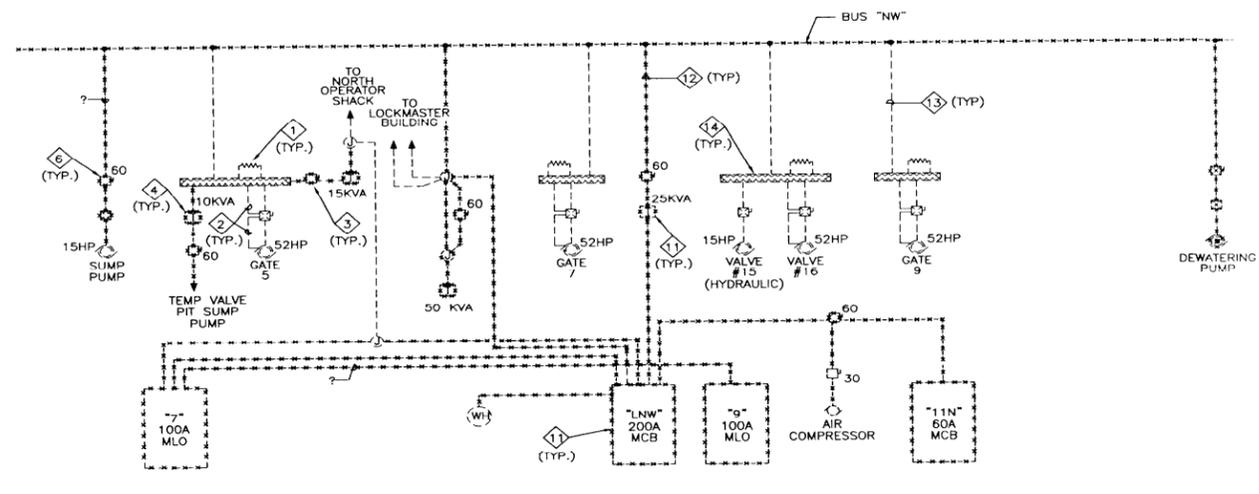

5 EXISTING ONE-LINE (WEST LAKE-END)  
SCALE: NONE

This drawing has been reduced to half size



© 2006 IMC 1404A CONSULTING ENGINEERS INC. 3120 20th STREET METAIRIE, LOUISIANA 70002

U. S. ARMY ENGINEER DISTRICT, NEW ORLEANS  
 CORPS OF ENGINEERS  
 NEW ORLEANS, LOUISIANA  
 DESIGN FILE NAME: J/480A/11E/C/E22  
 DRAWN BY: KJH  
 CHECKED BY: KJH  
 DATE: 02-17-05  
 SOLICITATION NO: W9298-06-9-0034  
 PERSON NUMBER: 19298-06-9-0034

INNER HARBOR NAVIGATION CANAL  
 ORLEANS PARISH, LA  
 EXISTING ELECTRICAL SYSTEM  
 ONE-LINE DIAGRAMS

FILE NUMBER  
 E22  
 DWG 24 OF 35

Safety is a Part of Your Contract



SEE SHEET E21 FOR SPECIFIC NOTES AND FEEDER SCHEDULE

2 REVISED ONE-LINE (EAST LAKE-END) SCALE: NONE

3 REVISED ONE-LINE (EAST RIVER-END AND GALLERY) SCALE: NONE

4 REVISED ONE-LINE (WEST RIVER-END AND GALLERY) SCALE: NONE

5 REVISED ONE-LINE (WEST LAKE-END) SCALE: NONE

This drawing has been reduced to half size


IMC CONSULTING ENGINEERS 3120 20th STREET METAIRIE, LOUISIANA 70002

U. S. ARMY ENGINEER DISTRICT, NEW ORLEANS... CORPS OF ENGINEERS... NEW ORLEANS, LOUISIANA... PROJECT NAME: 174044/elec/E23... DATE: 02-17-06

INNER HARBOR NAVIGATION CANAL... ORLEANS PARISH, LA... REVISED ELECTRICAL SYSTEM ONE-LINE DIAGRAMS

FILE NUMBER E23 DWG. 25 OF 35

Table with columns: MARK, DATE, REVISION, DESCRIPTION

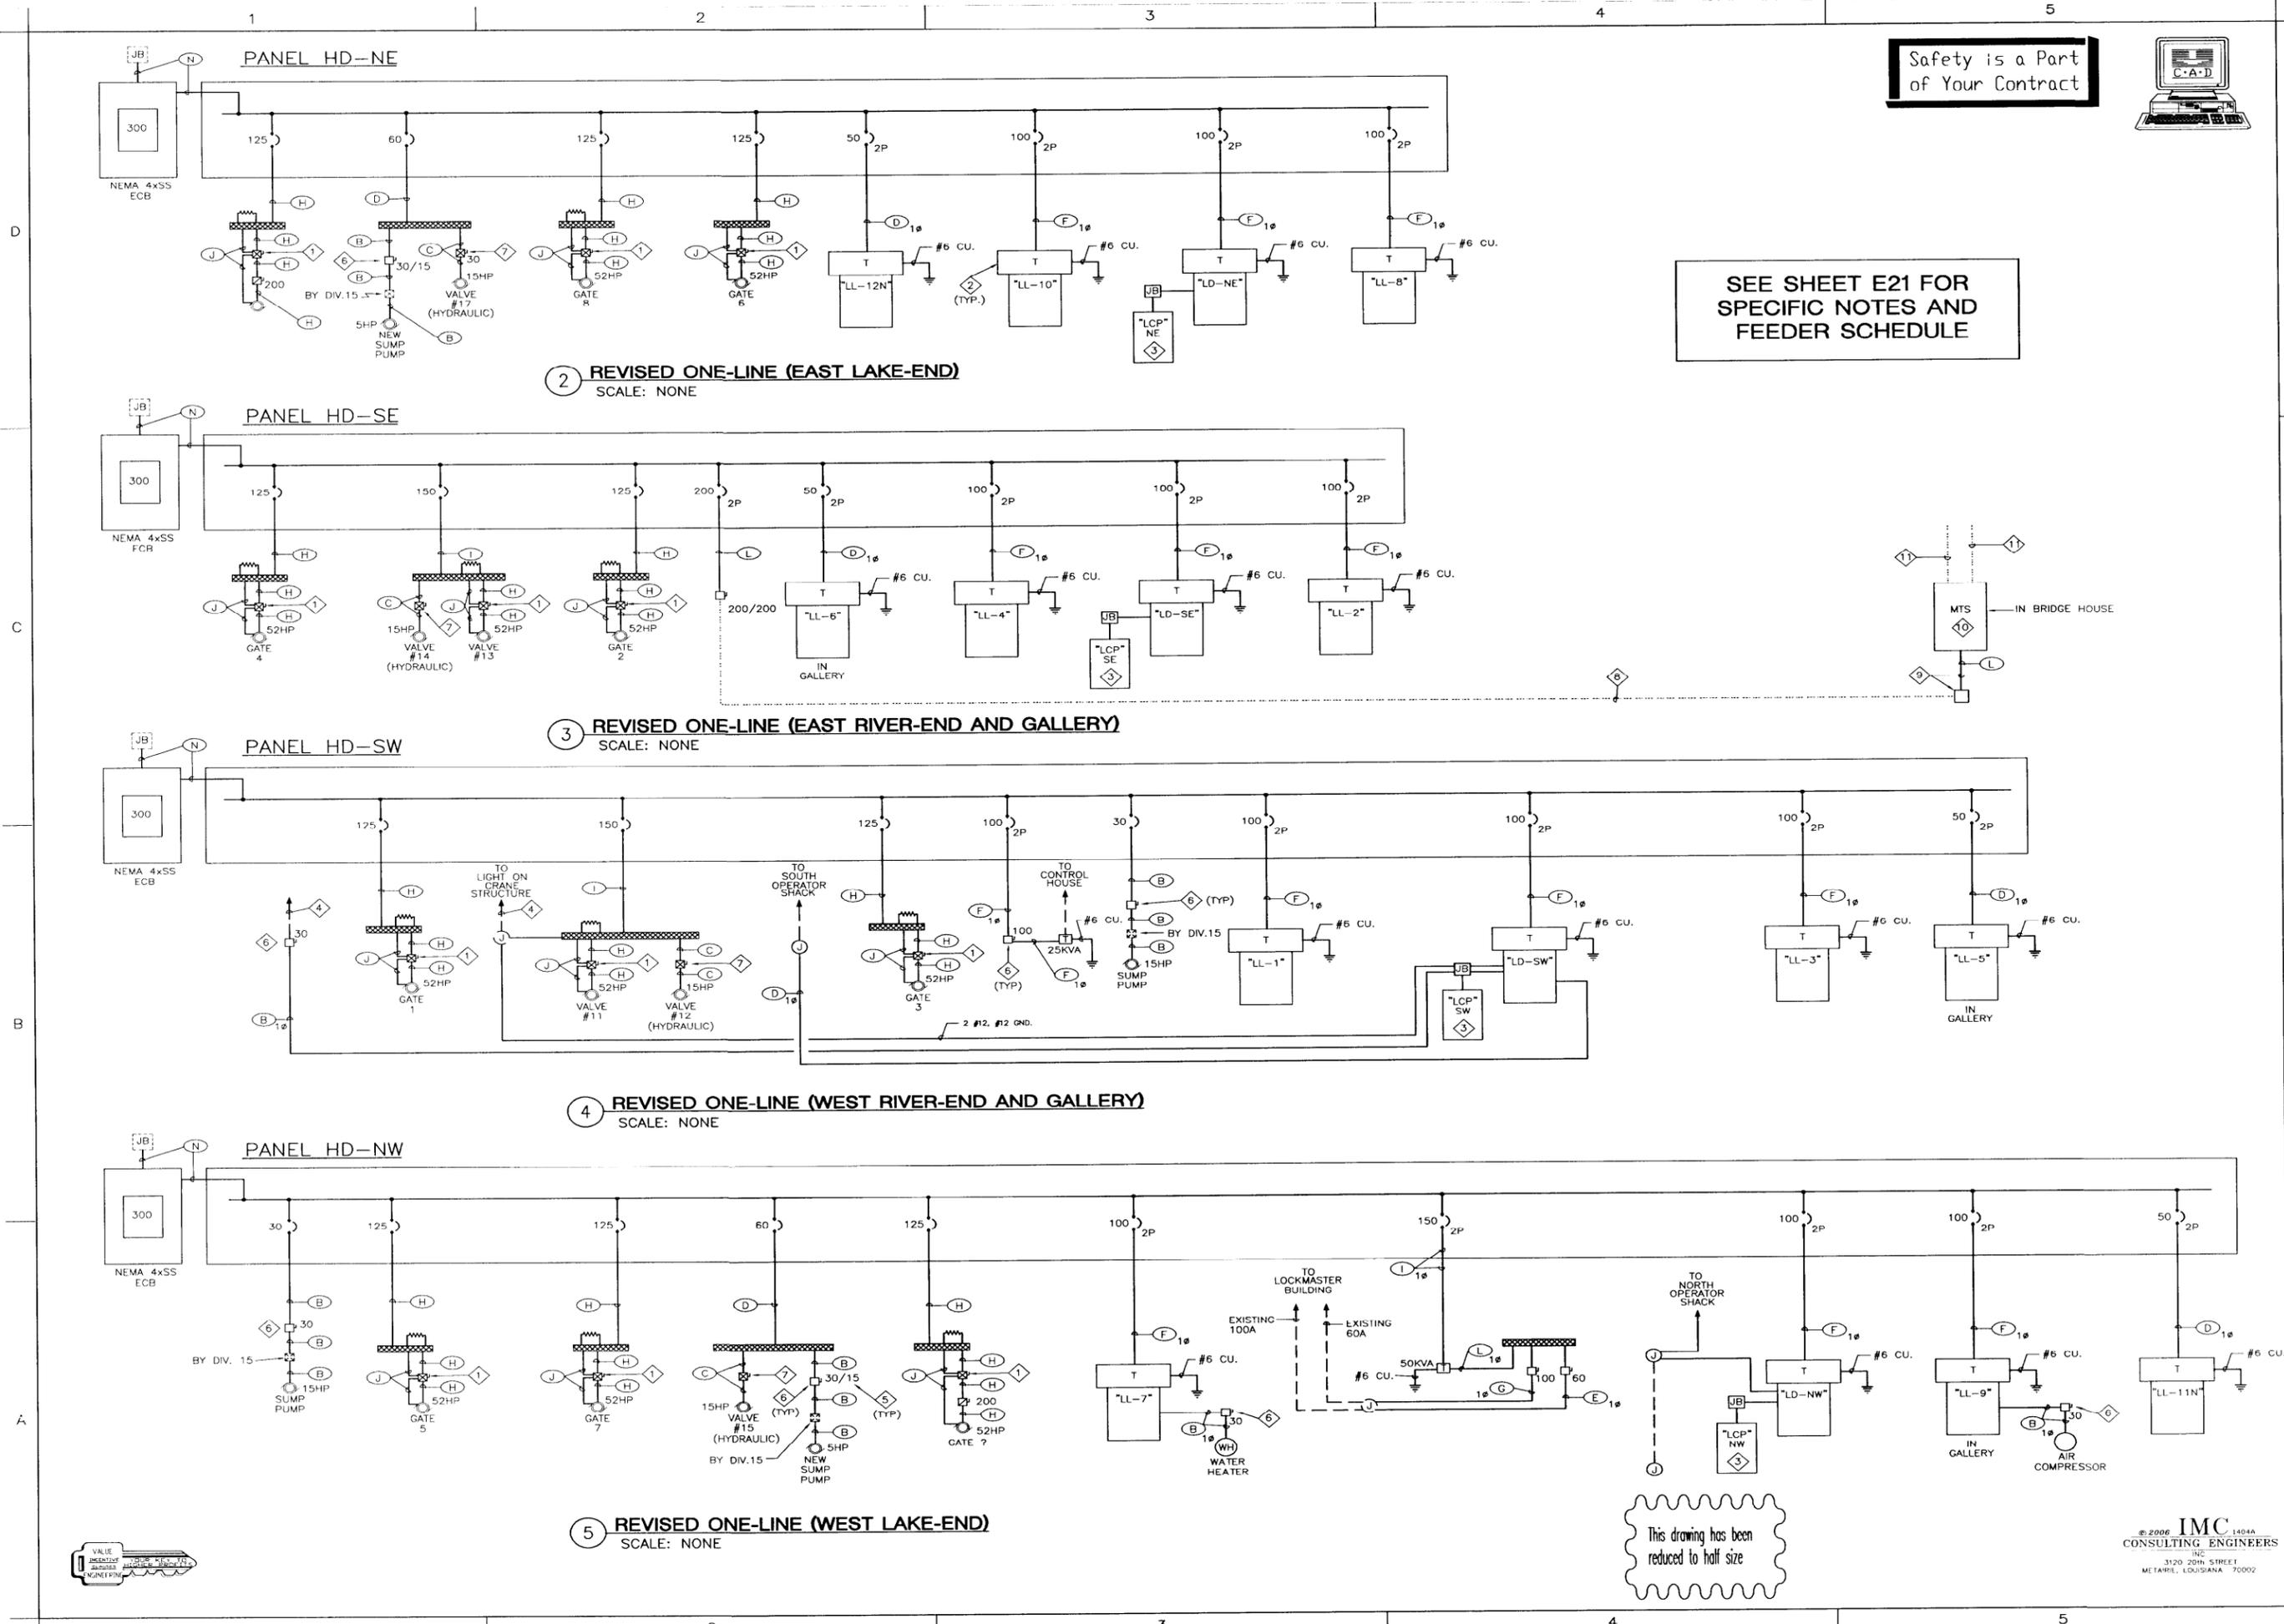



PANEL NAME		LD-NE		NUMBER OF PHASES		PROJECT NAME	
VOLTAGE		480		3		IHNC LOCK	
BUS SIZE (AMPS)		400		N		ELECTRICAL SYSTEM MODIFICATIONS	
MAIN CIRCUIT BREAKER SIZE		MLO		Y		PROJECT NUMBER: 1404A	
AIC RATING		14KA		SURFACE		DATE: 4/25/2006	
EST. SSC AMPS AVAIL.		<10KA		N		SECTION 1	

ITEM	AMP RATING	# POLES	CKT #	LEFT LOADING			RIGHT LOADING			CKT #	# POLES	AMP RATING	ITEM
				A	B	C	A	B	C				
1 GATE 6	125	3	1	21062			21062			2	125	GATE 8	
3				21062			21062			3			
5						21062				5			
7 VALVE 17 AND NEW SUMP PMP	60	3	3	7538			21062			4	125	GATE 10	
9				7538			21062			9			
11						7538				11			
13 LL-8	100	2	5	9628						2	100	SPACE	
15				9628						5			
17 LL-10	100	2	7			7870				2	100	SPACE	
19						7870				7			
21 LD-NE	100	2	0			1375			10	2	50	LL-12N	
23						1375			10	2	50		
25 SPACE	200	3							3	200		SPACE	
27									3	200			
29													
31													
33													
35													
37													
39													
41													

TOTAL CONNECTED LOAD (VA):		254222		1 LIGHTS		LOAD		DVRSTY		DMND		NOTES	
PHASE A LOADING (VA):		88222		2 RECEPT <= 10KVA		0		1.00		0		* PROVIDE FINAL TYPEWRITTEN DIRECTORY INSIDE PANEL	
PHASE B LOADING (VA):		83879		RECEPT > 10KVA		0		1.00		0		* PROVIDE ENGRAVED PLASTIC LABEL WITH PANEL DESIGNATION ON PANEL COVER	
PHASE C LOADING (VA):		82122		3 GATE MTR (LGST)		63186		1.00		63186		* ALL PANELS SHALL HAVE GROUND BARS AND BE GROUNDED TO CASE	
TOTAL CALCULATED LOAD (VA):		134601		4 GATE MTR		126372		0.50		0		* PANEL SHALL BE SQUARE D I-LINE TYPE (OR EQUAL) WITH NEMA 3R, STAINLESS STEEL ENCLOSURE	
				5 VALVES		22614		0.50		13568		* FURNISH WITH INTEGRAL TVSS MPSC=120KA	
				6 SUB PANEL		42050		1.00		0		* C/B'S OVER 100-AMPS SHALL BE PROVIDED WITH AN ADJUSTABLE MAGNETIC TRIP	
				7		0		1.00		0		* MAX HEIGHT= 68-INCHES, MAX WIDTH = 48-INCHES	
				8		0		1.00		0			
				9		0		1.00		0			
				10		0		1.00		0			

PANEL NAME		LD-NE		NUMBER OF PHASES		PROJECT NAME	
VOLTAGE		240		1		IHNC LOCK	
BUS SIZE (AMPS)		NA		Y		ELECTRICAL SYSTEM MODIFICATIONS	
POWER ZONE KVA RATING		25		SURFACE		PROJECT # 1404A	
MAIN CB SIZE (PRIMARY AMPS)		100		N		DATE: 4/25/2006	
MAIN CB SIZE (SECONDARY AMPS)		125		SECTION 1			

ITEM	AMP RATING	# POLES	CKT #	LEFT LOADING			RIGHT LOADING			CKT #	# POLES	AMP RATING	ITEM
				A	B	C	A	B	C				
1 SPARE	40	2	1							2	40	SPARE	
3										2			
5 SITE LIGHTING NORTH-EAST	20	2	3	1000						20	20	SPARE	
7				1000						2	20		
9 MITRE GATE FLOOD LIGHT	20	1		200						1	20	SPARE	
11 SPARE	20	1								1	20	SPARE	
13 SPACE												SPACE	
15 SPACE												SPACE	
17 SPACE												SPACE	
19 SPACE												SPACE	
21 SPACE												SPACE	
23 SPACE												SPACE	

TOTAL CONNECTED LOAD (VA):		2200		1 LIGHTS		LOAD		DVRSTY		DMND		NOTES	
PHASE A LOADING (VA):		1200		2 RECEPT <= 10KVA		0		1.00		0		* PROVIDE FINAL TYPEWRITTEN DIRECTORY INSIDE PANEL	
PHASE B LOADING (VA):		1000		RECEPT > 10KVA		0		0.50		0		* PROVIDE ENGRAVED PLASTIC LABEL WITH PANEL DESIGNATION ON PANEL COVER	
TOTAL CONNECTED LOAD (VA):		2200		3 EXISTING LOAD		0		1.00		0		* ALL CIRCUIT BREAKERS FEEDING FLUORESCENT LAMPS SHALL BE RATED TYPE SWD	
TOTAL CALCULATED LOAD (VA):		2750		5		0		1.00		0		* ALL CIRCUIT BREAKERS FEEDING HID LAMPS SHALL BE RATED TYPE HID	
				6		0		1.00		0		* ALL PANELS SHALL HAVE GROUND BARS AND BE GROUNDED TO CASE	
				7		0		1.00		0		* THIS PANEL IS PART OF A COMBINATION TRANSFORMER/ PANEL "MINI-POWER CENTER"	
				8		0		1.00		0		* PROVIDE MINI POWER CENTER WITH NEMA 3R STAINLESS STEEL ENCLOSURE	
				9		0		1.00		0			
				10		0		1.00		0			

PANEL NAME		LL-8		NUMBER OF PHASES		PROJECT NAME	
VOLTAGE		240		1		IHNC LOCK	
BUS SIZE (AMPS)		NA		Y		ELECTRICAL SYSTEM MODIFICATIONS	
POWER ZONE KVA RATING		25		SURFACE		PROJECT # 1404A	
MAIN CB SIZE (PRIMARY AMPS)		100		N		DATE: 4/25/2006	
MAIN CB SIZE (SECONDARY AMPS)		125		SECTION 1			

ITEM	AMP RATING	# POLES	CKT #	LEFT LOADING			RIGHT LOADING			CKT #	# POLES	AMP RATING	ITEM
				A	B	C	A	B	C				
1 G.P. RECEPTACLES	20	1	1	180			360			2	1	20	G.P. RECEPTACLES
3 G.P. RECEPTACLES	20	1	3				360			4	1	20	G.P. RECEPTACLES
5 POWER SHAFT (NORTH CROSSOVER)	20	1	5	500			770			6	1	20	MACHINERY ROOM LIGHTING
7 VALVE CHAMBER	20	1	7			500				8	1	20	MACHINERY ROOM LIGHTING
9 SPARE	20	1	9	0			6000			10	2	50	PORT PUMP RECEPT
11 SPARE	20	1	11	0			6000			10	2	50	
13 SPACE													SPACE
15 SPACE													SPACE
17 SPACE													SPACE
19 SPACE													SPACE
21 SPACE													SPACE
23 SPACE													SPACE

TOTAL CONNECTED LOAD (VA):		7810		1 LIGHTS		LOAD		DVRSTY		DMND		NOTES	
PHASE A LOADING (VA):		7810		2 RECEPT <= 10KVA		1080		1.00		1080		* CB'S SERVING PIT/SHAFT CKTS SHALL BE GFCI-TYPE	
PHASE B LOADING (VA):		7810		RECEPT > 10KVA		0		0.50		0		* PROVIDE FINAL TYPEWRITTEN DIRECTORY INSIDE PANEL	
TOTAL CONNECTED LOAD (VA):		15620		3 PORT PUMP RECEPT		12000		1.00		12000		* PROVIDE ENGRAVED PLASTIC LABEL WITH PANEL DESIGNATION ON PANEL COVER	
TOTAL CALCULATED LOAD (VA):		19255		4		0		1.00		0		* ALL CIRCUIT BREAKERS FEEDING FLUORESCENT LAMPS SHALL BE RATED TYPE SWD	
				5		0		1.00		0		* ALL CIRCUIT BREAKERS FEEDING HID LAMPS SHALL BE RATED TYPE HID	
				6		0		1.00		0		* ALL PANELS SHALL HAVE GROUND BARS AND BE GROUNDED TO CASE	
				7		0		1.00		0		* THIS PANEL IS PART OF A COMBINATION TRANSFORMER/ PANEL "MINI-POWER CENTER"	
				8		0		1.00		0		* PROVIDE MINI POWER CENTER WITH NEMA 3R STAINLESS STEEL ENCLOSURE	
				9		0		1.00		0			
				10		0		1.00		0			

PANEL NAME		LL-10		NUMBER OF PHASES		PROJECT NAME	
VOLTAGE		240		1		IHNC LOCK	
BUS SIZE (AMPS)		NA		Y		ELECTRICAL SYSTEM MODIFICATIONS	
POWER ZONE KVA RATING		25		SURFACE		PROJECT # 1404A	
MAIN CB SIZE (PRIMARY AMPS)		100		N		DATE: 4/25/2006	
MAIN CB SIZE (SECONDARY AMPS)		125		SECTION 1			

ITEM	AMP RATING	# POLES	CKT #	LEFT LOADING			RIGHT LOADING			CKT #	# POLES	AMP RATING	ITEM
				A	B	C	A	B	C				
1 G.P. RECEPTACLES	20	1	1	360			360			2	1	20	G.P. RECEPTACLES
3 G.P. RECEPTACLES	20	1	3				360			4	1	20	G.P. RECEPTACLES
5 SPARE	20	1	5	0			420			6	1	20	MACHINERY ROOM LIGHTING
7 VALVE CHAMBERS	20	1	7			1000				8	1	20	MACHINERY ROOM LIGHTING
9 SPARE	20	1	9	0			6000			10	2	50	PORT PUMP RECEPT
11 SPARE	20	1	11	0			6000			10	2	50	
13 SPACE													SPACE
15 SPACE													SPACE
17 SPACE													SPACE
19 SPACE													SPACE
21 SPACE													SPACE
23 SPACE													SPACE

TOTAL CONNECTED LOAD (VA):		7140		1 LIGHTS		LOAD		DVRSTY		DMND		NOTES	
PHASE A LOADING (VA):		8140		2 RECEPT <= 10KVA		1440		1.00		1440		* CB'S SERVING PIT/SHAFT CKTS SHALL BE GFCI-TYPE	
PHASE B LOADING (VA):		8140		RECEPT > 10KVA		0		0.50		0		* PROVIDE FINAL TYPEWRITTEN DIRECTORY INSIDE PANEL	
TOTAL CONNECTED LOAD (VA):		15280		3 PORT PUMP RECEPT		12000		1.00		12000		* PROVIDE ENGRAVED PLASTIC LABEL WITH PANEL DESIGNATION ON PANEL COVER	
TOTAL CALCULATED LOAD (VA):		15740		4		0		1.00		0		* ALL CIRCUIT BREAKERS FEEDING FLUORESCENT LAMPS SHALL BE RATED TYPE SWD	
				5		0		1.00		0		* ALL CIRCUIT BREAKERS FEEDING HID LAMPS SHALL BE RATED TYPE HID	
				6		0		1.00		0		* ALL PANELS SHALL HAVE GROUND BARS AND BE GROUNDED TO CASE	
				7		0		1.00		0		* THIS PANEL IS PART OF A COMBINATION TRANSFORMER/ PANEL "MINI-POWER CENTER"	
				8		0		1.00		0		* PROVIDE MINI POWER CENTER WITH NEMA 3R STAINLESS STEEL ENCLOSURE	
				9		0		1.00		0			
				10		0		1.00		0			

PANEL NAME		LL-12N		NUMBER OF PHASES		PROJECT NAME	
VOLTAGE		240		1		IHNC LOCK	
BUS SIZE (AMPS)		NA		Y		ELECTRICAL SYSTEM MODIFICATIONS	
POWER ZONE KVA RATING		10		SURFACE		PROJECT # 1404A	
MAIN CB SIZE (PRIMARY AMPS)		40		N		DATE: 12/29/2005	
MAIN CB SIZE (SECONDARY AMPS)		60		SECTION 1			

ITEM	AMP RATING	# POLES	CKT #	LEFT LOADING			RIGHT LOADING			CKT
------	------------	---------	-------	--------------	--	--	---------------	--	--	-----

PANEL NAME		LD-SW		NUMBER OF PHASES		PROJECT NAME	
VOLTAGE		480		3		IHNC LOCK	
BUS SIZE (AMPS)		400		N		ELECTRICAL SYSTEM MODIFICATIONS	
MAIN CIRCUIT BREAKER SIZE		MLO		Y		1404A	
AIC RATING		14KA		SURFACE		PROJECT #	
EST. SSC AMPS AVAILABLE		<10KA		N		DATE	
				FEED-THRU LUGS		4/25/2006	
				OTHER OPTIONS			

SECTION 1		LEFT LOADING			RIGHT LOADING			SECTION 1			
ITEM	AMP RATING	# POLES	CKT #	A	B	C	A	B	C	ITEM	AMP RATING
1 GATE 1	125	3	1	21062			21062			GATE 3	125
3 "				21062			21062			"	
5 "				21062			21062			"	
7 VALVES 11 AND 12	150	3	3	26383			5820			NEW SUMP PUMP	30
9 "				26383			5820			"	
11 "				26383			5820			"	
13 LL-1	100	2	5	8795			12500			CONTROL HOUSE	100
15 "				8795			12500			"	
17 LL-3	100	2	7	9288						SPACE	100
19 "				9288						"	
21 LL-5	50	2	9	2493			9625			LD-SV	100
23 "				2493			9625			"	
25 SPACE	200	3	11							SPACE	200
27 "										"	
29 "										"	
31 "										"	
33 "										"	
35 "										"	
37 "										"	
39 "										"	
41 "										"	
				65528	58733	59225	39382	49007	36507		

TOTAL CONNECTED LOAD (VA):		LOAD		DVRSTY		DMIND		NOTES	
PHASE A LOADING (VA):	308381	1 LIGHTS	0	1.00	0			* PROVIDE FINAL TYPEWRITTEN DIRECTORY INSIDE PANEL	
PHASE B LOADING (VA):	104910	2 RECEPT <= 10KVA	0	1.00	0			* PROVIDE ENGRAVED PLASTIC LABEL WITH PANEL DESIGNATION ON PANEL COVER	
PHASE R LOADING (VA):	107740	RECEPT > 10KVA	0	0.50	0			* ALL CIRCUIT BREAKERS FEEDING FLUORESCENT LAMPS SHALL BE RATED TYPE SWD	
PHASE C LOADING (VA):	95732	3 GATE MTR (LGST)	63186	1.00	63186			* ALL CIRCUIT BREAKERS FEEDING HID LAMPS SHALL BE RATED TYPE HID	
TOTAL CALCULATED LOAD (VA):	181843	4 GATE MTR	63186	0.00	0			* ALL PANELS SHALL HAVE GROUND BARS AND BE GROUNDED TO CASE	
		5 VALVES	79149	0.00	0			* PANEL SHALL BE SQUARE D I-LINE TYPE (OR EQUAL) WITH NEMA 3R, STAINLESS STEEL ENCLOSURE	
		6 SUMP PUMP	17460	1.00	17460			* FURNISH WITH INTEGRAL TVSS MPSC=120KA	
		7 SUB PANEL	85400	1.00	85400			* CB'S OVER 100-AMPS SHALL BE PROVIDED WITH AN ADJUSTABLE MAGNETIC TRIP	
TOTAL CALCULATED LOAD (A):	219	8	0	1.00	0			* MAX HEIGHT = 68-INCHES, MAX WIDTH = 48-INCHES	
		9	0	1.00	0				
		10	0	1.00	0				

PANEL NAME		LD-SW		NUMBER OF PHASES		PROJECT NAME	
VOLTAGE		240		1		IHNC LOCK	
BUS SIZE (AMPS)		NA		Y		ELECTRICAL SYSTEM MODIFICATIONS	
POWER ZONE KVA RATING		25		SURFACE		PROJECT #	
MAIN CB SIZE (PRIMARY AMPS)		100		N		DATE	
MAIN CB SIZE (SECONDARY AMPS)		125		OTHER OPTIONS			

SECTION 1		LEFT LOADING			RIGHT LOADING			SECTION 1			
ITEM	AMP RATING	# POLES	CKT #	A	B	C	A	B	C	ITEM	AMP RATING
1 SPARE	40	2	1				6000			SOUTH OPERATOR SHACK	40
3 "							6000			"	
5 EXISTING 3 KVA LOAD	20	2	3	1500			1500			SITE LIGHTING CENTER WEST	20
7 "				1500			1500			"	
9 MITRE GATE FLOOD LIGHT	20	1	5	200			0			SPARE	20
11 LIGHT ON CRANE STRUCT	20	1	7	200			0			SPARE	20
13 SPACE										SPACE	
15 SPACE										SPACE	
17 SPACE										SPACE	
19 SPACE										SPACE	
21 SPACE										SPACE	
23 SPACE										SPACE	
				1700	1700	0	7500	7500	0		

TOTAL CONNECTED LOAD (VA):		LOAD		DVRSTY		DMIND		NOTES	
PHASE A LOADING (VA):	9200	1 LIGHTS	3400	1.00	3400			* PROVIDE FINAL TYPEWRITTEN DIRECTORY INSIDE PANEL	
PHASE B LOADING (VA):	9200	2 RECEPT <= 10KVA	0	1.00	0			* PROVIDE ENGRAVED PLASTIC LABEL WITH PANEL DESIGNATION ON PANEL COVER	
TOTAL CONNECTED LOAD (VA):	18400	3 OPER SHACK	12000	1.00	12000			* ALL CIRCUIT BREAKERS FEEDING FLUORESCENT LAMPS SHALL BE RATED TYPE SWD	
TOTAL CALCULATED LOAD (VA):	19250	4 EXISTING LOAD	3000	1.00	3000			* ALL CIRCUIT BREAKERS FEEDING HID LAMPS SHALL BE RATED TYPE HID	
		5	0	1.00	0			* ALL PANELS SHALL HAVE GROUND BARS AND BE GROUNDED TO CASE	
		6	0	1.00	0			* THIS PANEL IS PART OF A COMBINATION TRANSFORMER/PANEL "MINI-POWER CENTER"	
TOTAL CONNECTED LOAD (A):	77	7	0	1.00	0			* PROVIDE MINI POWER CENTER WITH NEMA 3R STAINLESS STEEL ENCLOSURE	
TOTAL CALCULATED LOAD (A):	80	8	0	1.00	0				
		9	0	1.00	0				
		10	0	1.00	0				

PANEL NAME		LD-SW		NUMBER OF PHASES		PROJECT NAME	
VOLTAGE		240		1		IHNC LOCK	
BUS SIZE (AMPS)		NA		Y		ELECTRICAL SYSTEM MODIFICATIONS	
POWER ZONE KVA RATING		25		SURFACE		PROJECT #	
MAIN CB SIZE (PRIMARY AMPS)		100		N		DATE	
MAIN CB SIZE (SECONDARY AMPS)		125		OTHER OPTIONS			

SECTION 1		LEFT LOADING			RIGHT LOADING			SECTION 1			
ITEM	AMP RATING	# POLES	CKT #	A	B	C	A	B	C	ITEM	AMP RATING
1 G.P. RECEPTACLES	20	1	1	360			360			G.P. RECEPTACLES	20
3 G.P. RECEPTACLES	20	1	3				360			G.P. RECEPTACLES	20
5 VALVE CHAMBER	20	1	5	500			500			MACHINERY ROOM LIGHTING	20
7 VALVE CHAMBERS	20	1	7	1000			500			MACHINERY ROOM LIGHTING	20
9 SPARE	20	2	9				6000			PORT PUMP RECEPT	20
11 "							6000			"	
13 PANEL 1 EXISTING LOAD (?)	20	1	11	1000			0			SPARE	20
15 SPARE	20	1	13				0			SPARE	20
17 SPACE										SPACE	
19 SPACE										SPACE	
21 SPACE										SPACE	
23 SPACE										SPACE	
				1860	1360	0	6920	6920	0		

TOTAL CONNECTED LOAD (VA):		LOAD		DVRSTY		DMIND		NOTES	
PHASE A LOADING (VA):	8780	1 LIGHTS	2120	1.00	2120			* CB'S SERVING PIT/SHAFT CKTS SHALL BE GFCI TYPE	
PHASE B LOADING (VA):	8280	2 RECEPT <= 10KVA	1940	1.00	1940			* PROVIDE FINAL TYPEWRITTEN DIRECTORY INSIDE PANEL	
TOTAL CONNECTED LOAD (VA):	17060	RECEPT > 10KVA	0	0.50	0			* PROVIDE ENGRAVED PLASTIC LABEL WITH PANEL DESIGNATION ON PANEL COVER	
TOTAL CALCULATED LOAD (VA):	17590	3 EXISTING LOAD	1000	1.00	1000			* ALL CIRCUIT BREAKERS FEEDING FLUORESCENT LAMPS SHALL BE RATED TYPE SWD	
		4 PORT PUMP RECEPT	12000	1.00	12000			* ALL CIRCUIT BREAKERS FEEDING HID LAMPS SHALL BE RATED TYPE HID	
		5	0	1.00	0			* ALL PANELS SHALL HAVE GROUND BARS AND BE GROUNDED TO CASE	
TOTAL CONNECTED LOAD (A):	71	6	0	1.00	0			* THIS PANEL IS PART OF A COMBINATION TRANSFORMER/PANEL "MINI-POWER CENTER"	
TOTAL CALCULATED LOAD (A):	73	7	0	1.00	0			* PROVIDE MINI POWER CENTER WITH NEMA 3R STAINLESS STEEL ENCLOSURE	
		8	0	1.00	0				
		9	0	1.00	0				
		10	0	1.00	0				

PANEL NAME		LD-SW		NUMBER OF PHASES		PROJECT NAME	
VOLTAGE		240		1		IHNC LOCK	
BUS SIZE (AMPS)		NA		Y		ELECTRICAL SYSTEM MODIFICATIONS	
POWER ZONE KVA RATING		25		SURFACE		PROJECT #	
MAIN CB SIZE (PRIMARY AMPS)		100		N		DATE	
MAIN CB SIZE (SECONDARY AMPS)		125		OTHER OPTIONS			

SECTION 1		LEFT LOADING			RIGHT LOADING			SECTION 1			
ITEM	AMP RATING	# POLES	CKT #	A	B	C	A	B	C	ITEM	AMP RATING
1 G.P. RECEPTACLES	20	1	1	180			360			G.P. RECEPTACLES	20
3 G.P. RECEPTACLES	20	1	3				360			SPARE	20
5 POWER SHAFT (SOUTH CROSSOVER)	20	1	5	500			420			MACHINERY ROOM LIGHTING	20
7 SPARE	20	1	7				420			MACHINERY ROOM LIGHTING	20
9 PANEL 3 EXISTING LOAD ?	30	1	9	2000			6000			PORT PUMP RECEPT	30
11 PANEL 3 EXISTING LOAD ?	30	1	11	2000			6000			"	30
13 SPACE										SPACE	
15 SPACE										SPACE	
17 SPACE										SPACE	
19 SPACE										SPACE	
21 SPACE										SPACE	
23 SPACE										SPACE	
				2680	2360	0	6780	6420	0		

TOTAL CONNECTED LOAD (VA):		LOAD		DVRSTY		DMIND		NOTES	
PHASE A LOADING (VA):	9460	1 LIGHTS	1340	1.00	1340			* CB'S SERVING PIT/SHAFT CKTS SHALL BE GFCI TYPE	
PHASE B LOADING (VA):	6780	2 RECEPT <= 10KVA	900	1.00	900			* PROVIDE FINAL TYPEWRITTEN DIRECTORY INSIDE PANEL	
TOTAL CONNECTED LOAD (VA):	16240	RECEPT > 10KVA	0	0.50	0			* PROVIDE ENGRAVED PLASTIC LABEL WITH PANEL DESIGNATION ON PANEL COVER	
TOTAL CALCULATED LOAD (VA):	16575	3 PORT PUMP RECEPT	12000	1.00	12000			* ALL CIRCUIT BREAKERS FEEDING FLUORESCENT LAMPS SHALL BE RATED TYPE SWD	
		4 EXISTING LOAD	4000	1.00	4000			* ALL CIRCUIT BREAKERS FEEDING HID LAMPS SHALL BE RATED TYPE HID	
		5	0	1.00	0			* ALL PANELS SHALL HAVE GROUND BARS AND BE GROUNDED TO CASE	
TOTAL CONNECTED LOAD (A):	76	6	0	1.00	0			* THIS PANEL IS PART OF A COMBINATION TRANSFORMER/PANEL "MINI-POWER CENTER"	
TOTAL CALCULATED LOAD (A):	77	7	0	1.00	0			* PROVIDE MINI POWER CENTER WITH NEMA 3R STAINLESS STEEL ENCLOSURE	
		8	0	1.00	0				
		9	0	1.00	0				
		10	0	1.00	0				

PANEL NAME		LD-SW		NUMBER OF PHASES		PROJECT NAME	
VOLTAGE		240		1		IHNC LOCK	
BUS SIZE (AMPS)		NA		Y		ELECTRICAL SYSTEM MODIFICATIONS	
POWER ZONE KVA RATING		10		SURFACE		PROJECT #	
MAIN CB SIZE (PRIMARY AMPS)		40		N		DATE	
MAIN CB SIZE (SECONDARY AMPS)		60		OTHER OPTIONS			



  

SECTION 1		LEFT LOADING			RIGHT LOADING			SECTION 1			
ITEM	AMP RATING	# POLES	CKT #	A	B	C	A	B	C	ITEM	AMP RATING
1 G.P. RECEPTACLES	20	1	1	360			1050			GALLERY LIGHTING	20
3 SPARE	20	1	3								





Safety is a Part  
of Your Contract

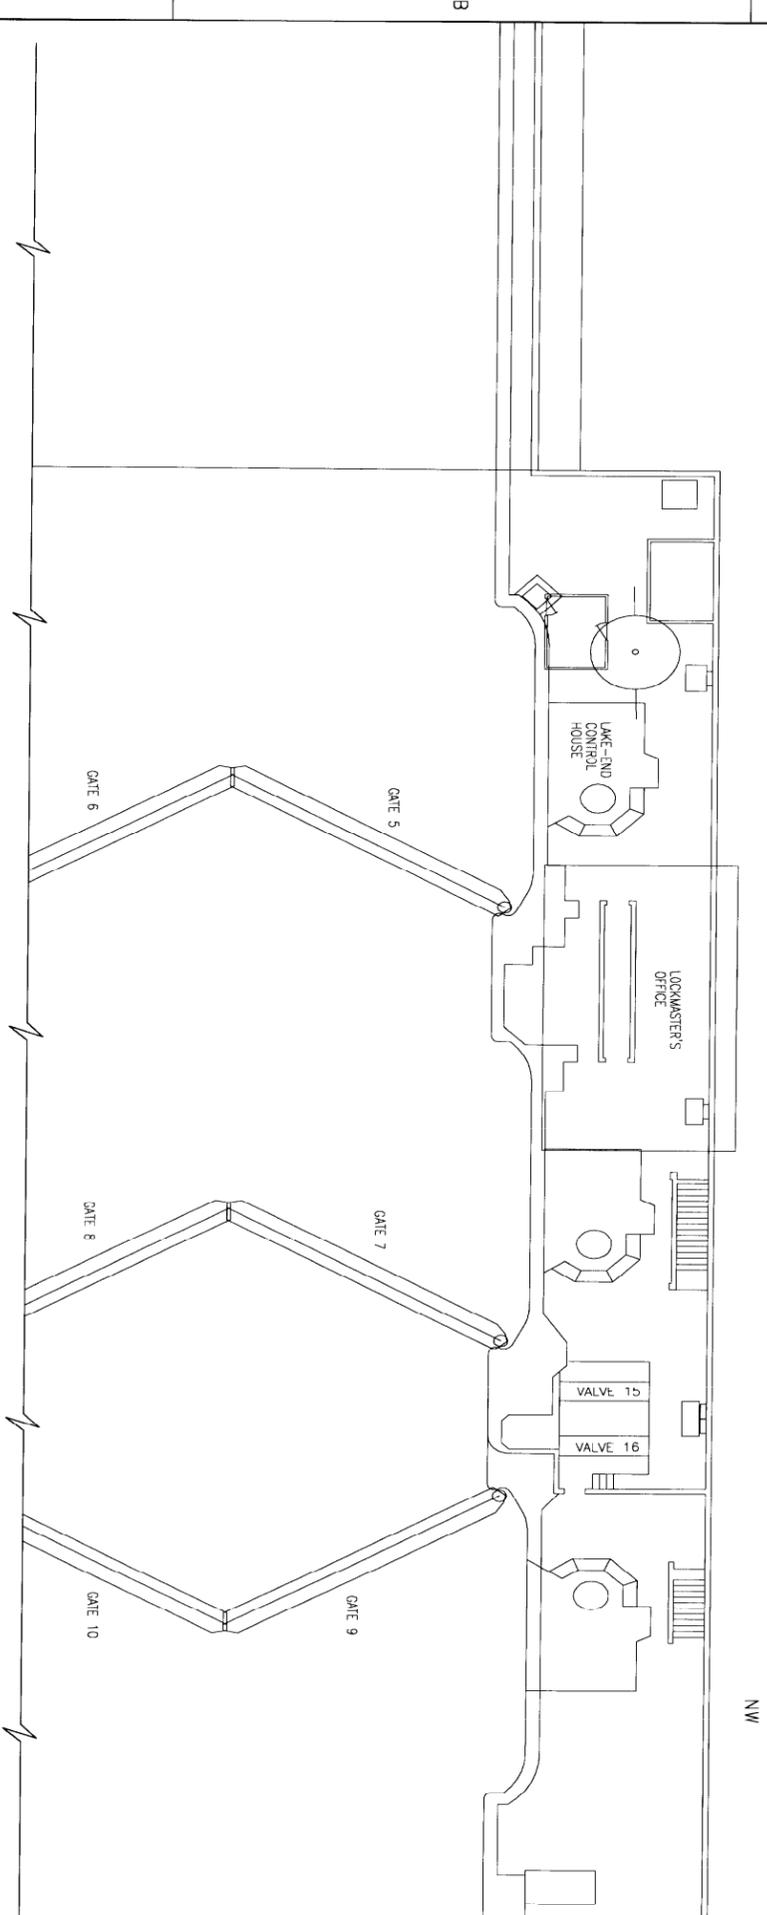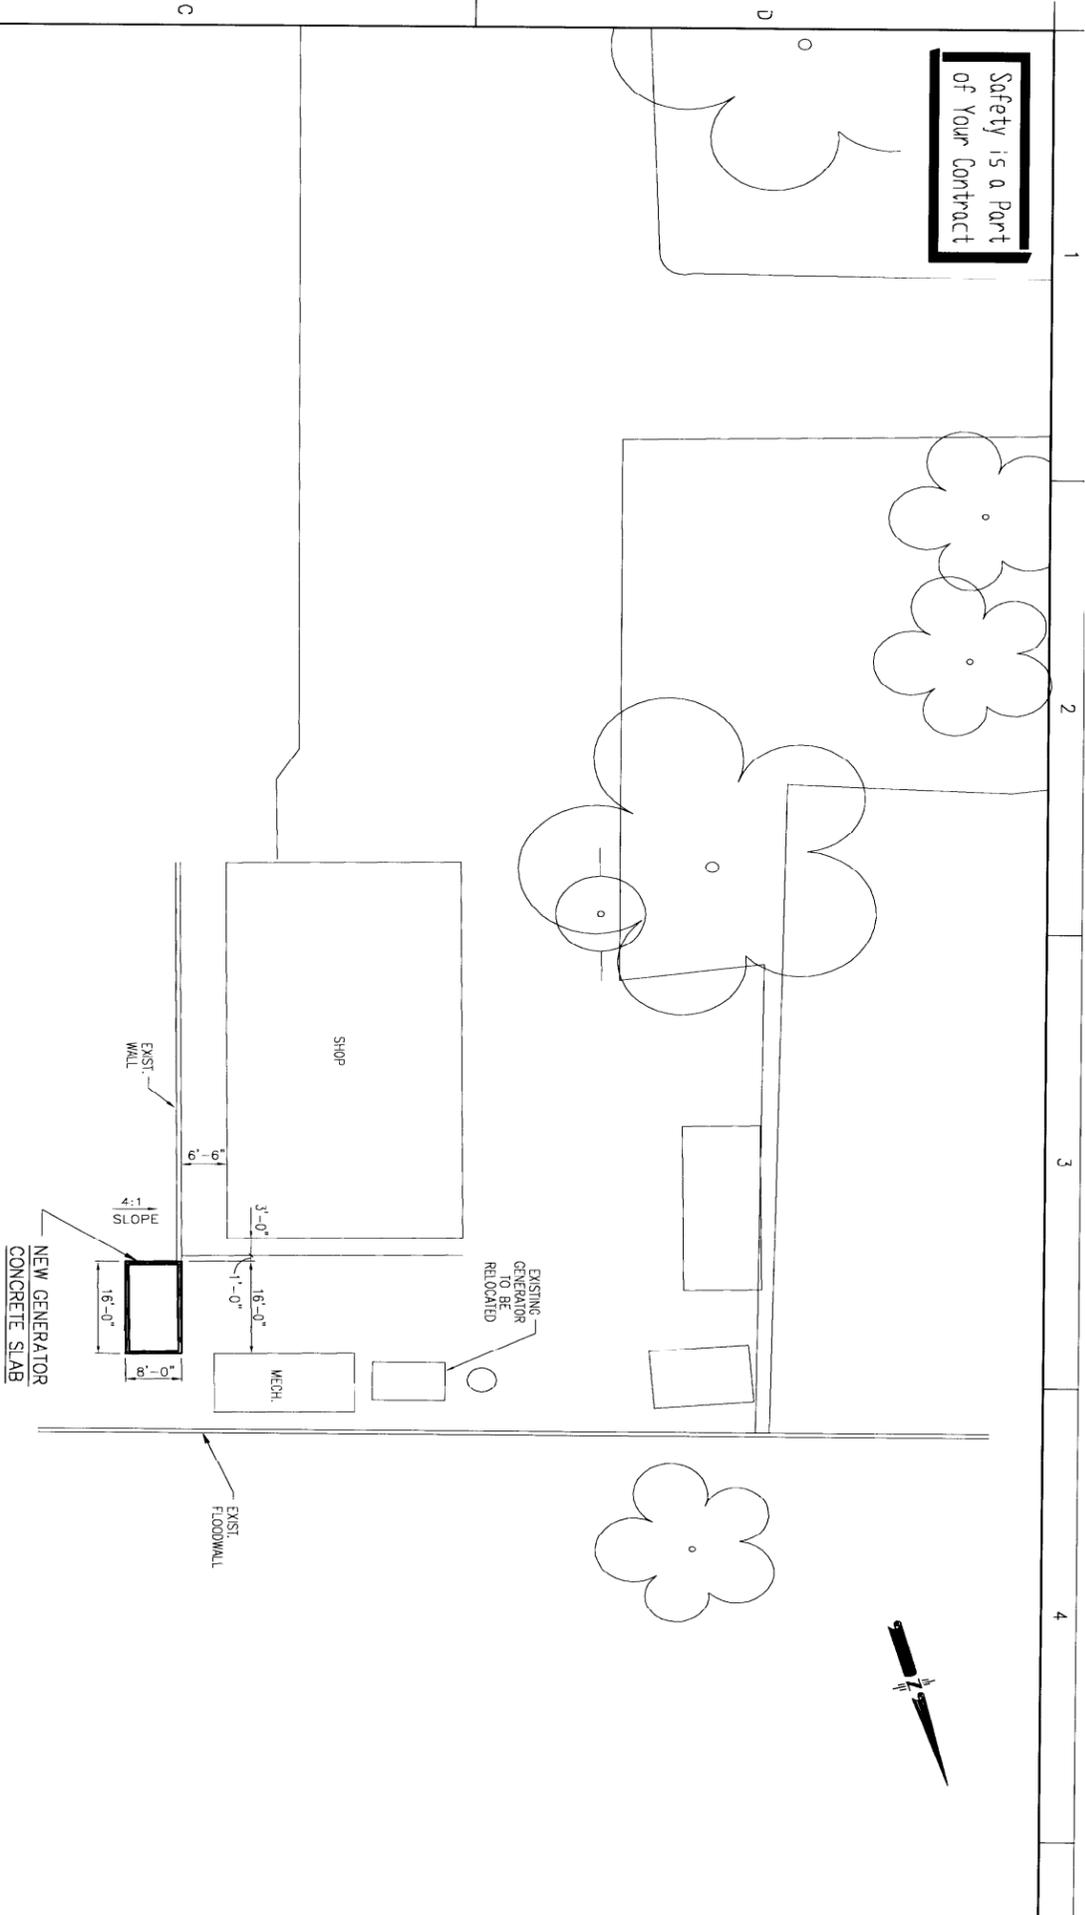

**GENERATOR LOCATION PLAN**


SCALE: 1" = 10'-0"



This drawing has been  
reduced to half size


FOR CONSTRUCTION  
FEB. 17, 2006

Safety is a Part  
of Your Contract

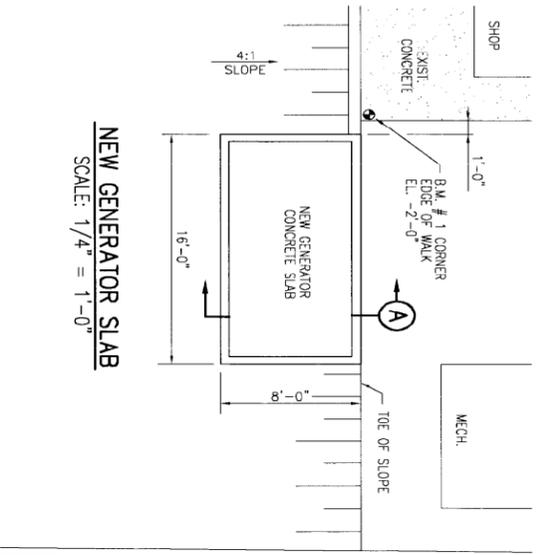


**NEW GENERATOR SLAB**  
SCALE: 1/4" = 1'-0"

NOTE:  
CONTRACTOR SHALL COORDINATE WITH ELECT. TO DETERMINE NUMBER & LOCATION OF BOLT HOLES TO BE DRILLED. EXISTING BOLT HOLES SHALL BE FILLED WITH EPOXY GROUT.

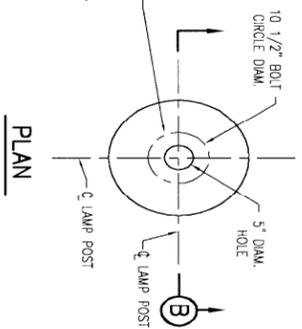


**PLAN**

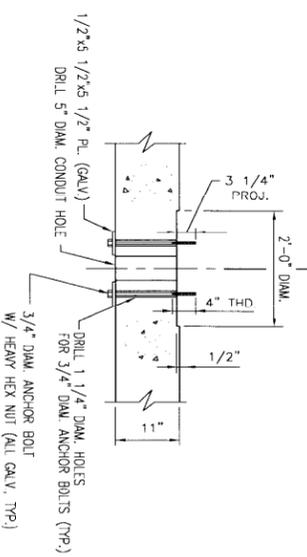


**SECTION**


**LAMP POST ANCHORAGE DETAIL**  
SCALE: 1" = 1'-0"

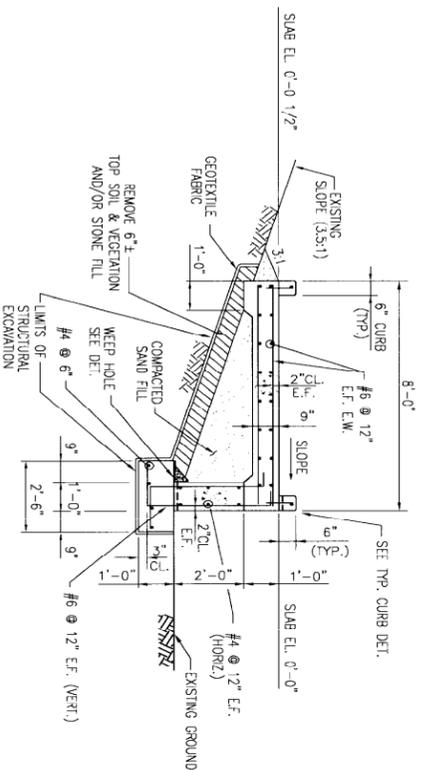


**SECTION A-A**  
SCALE: 1/2" = 1'-0"

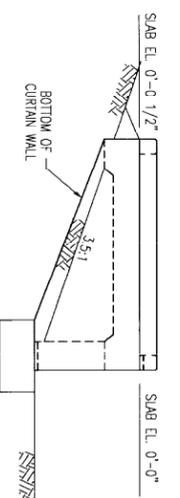


**NORTH ELEVATION**  
SCALE: 1/2" = 1'-0"

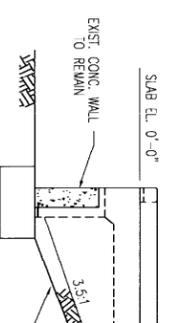


**SOUTH EL.**  
SCALE: 1/2" = 1'-0"

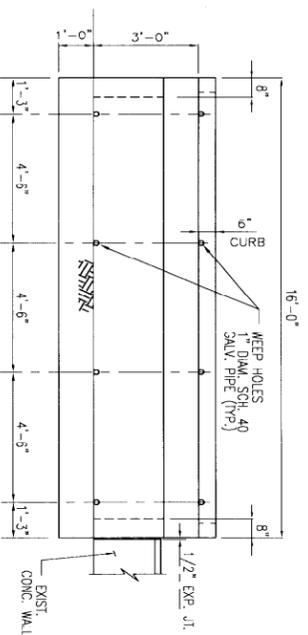

**WEST ELEVATION**  
SCALE: 1/2" = 1'-0"

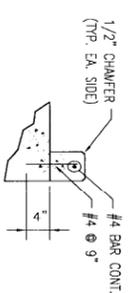


**TYP. CURB DET.**  
SCALE: 1" = 1'-0"

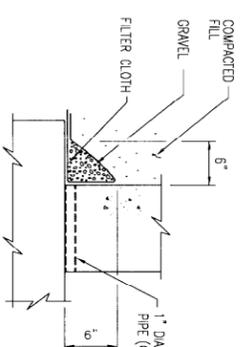

**WEEP HOLE**  
SCALE: 1 1/2" = 1'-0"

This drawing has been  
reduced to half size

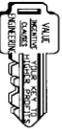

FOR CONSTRUCTION  
FEB. 17, 2006

SCALE: 1/4" = 1'-0"  
12" 0 5' 10' 15' 20'

SCALE: 1/2" = 1'-0"  
1/2" 0 2' 4' 6' 8'

SCALE: 1" = 1'-0"  
12" 0 1' 2' 3' 4'

SCALE: 1 1/2" = 1'-0"  
12" 0 1' 2' 3'

1

2

3

4







1

2

3

4

Safety is a Part  
of Your Contract

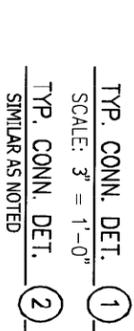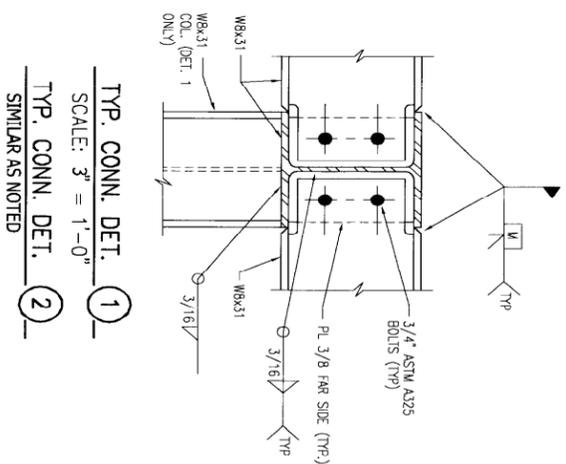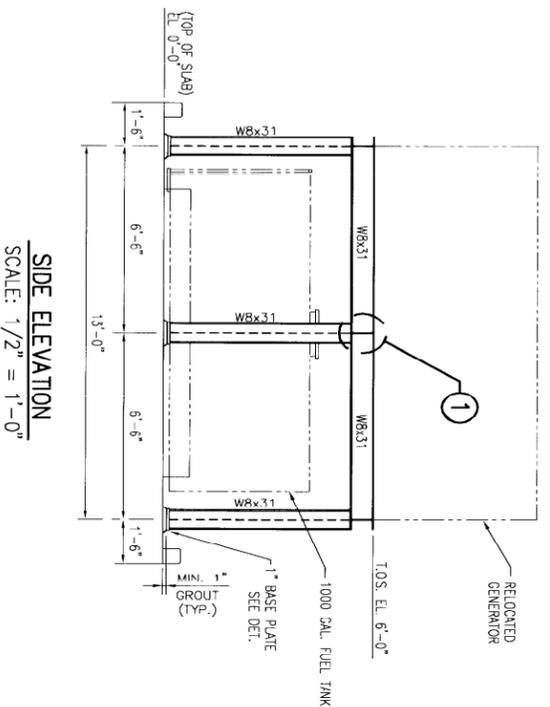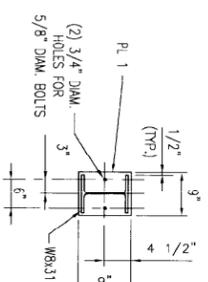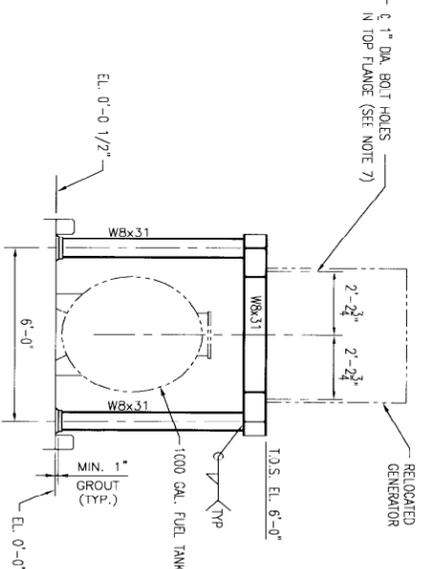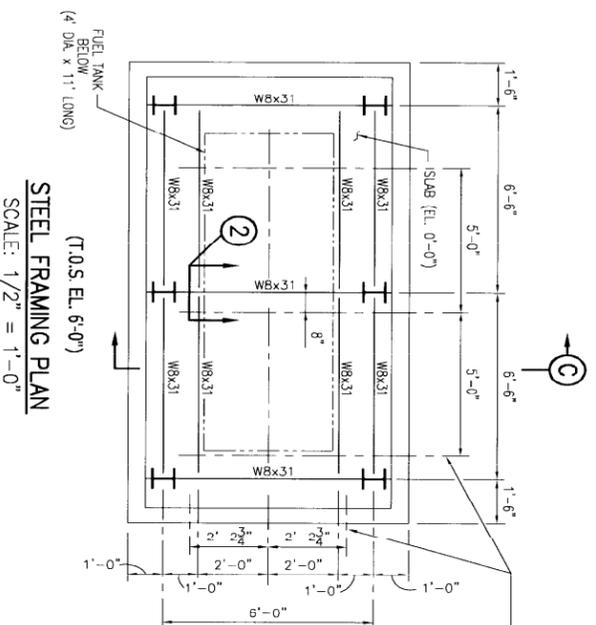

- NOTES:**
1. STRUCTURAL STEEL SHALL BE ASTM A36. ALL STEEL SHALL EQUAL.
  2. ANCHOR BOLTS SHALL BE HULTI KWIK-BOLT 5/8" DIA. STAINLESS STEEL.
  3. FUEL TANK SHALL BE 4'-0" DIA. x 11'-0" LONG DOUBLE END BRACKET TYPE. WARRON, IOWA OR EQUAL, OR APPROVED PER MANUFACTURER'S REQUIREMENTS.
  4. FABRICATION AND ERECTION SHALL BE IN ACCORDANCE WITH CURRENT STANDARDS OF AMERICAN INSTITUTE OF STEEL CONSTRUCTION.
  5. WELDING SHALL MEET REQUIREMENTS OF THE AMERICAN WELDING SOCIETY.
  6. GROUT UNDER BASE PLATES SHALL BE NONSHRINK GROUT.
  7. CONTRACTOR TO VERIFY LOCATIONS OF BOLT HOLES BEFORE ERECTION.

SCALE: 1/2" = 1'-0"

SCALE: 1" = 1'-0"

SCALE: 3" = 1'-0"

SCALE: 1" = 1'-0"

This drawing has been  
reduced to full size

FOR CONSTRUCTION  
FEB 17, 2006




1

2


3

4




**Safety is a Part  
of Your Contract**

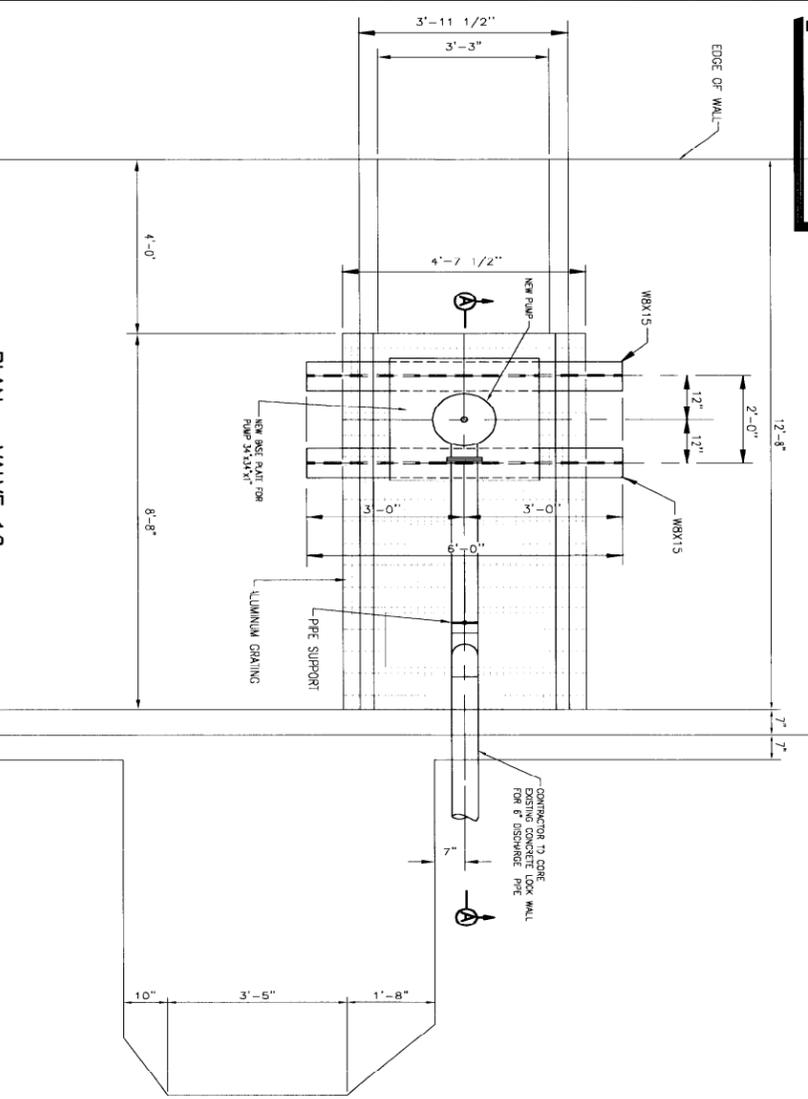

**PLAN - VALVE 16**  
SCALE 3/4"=1'-0"

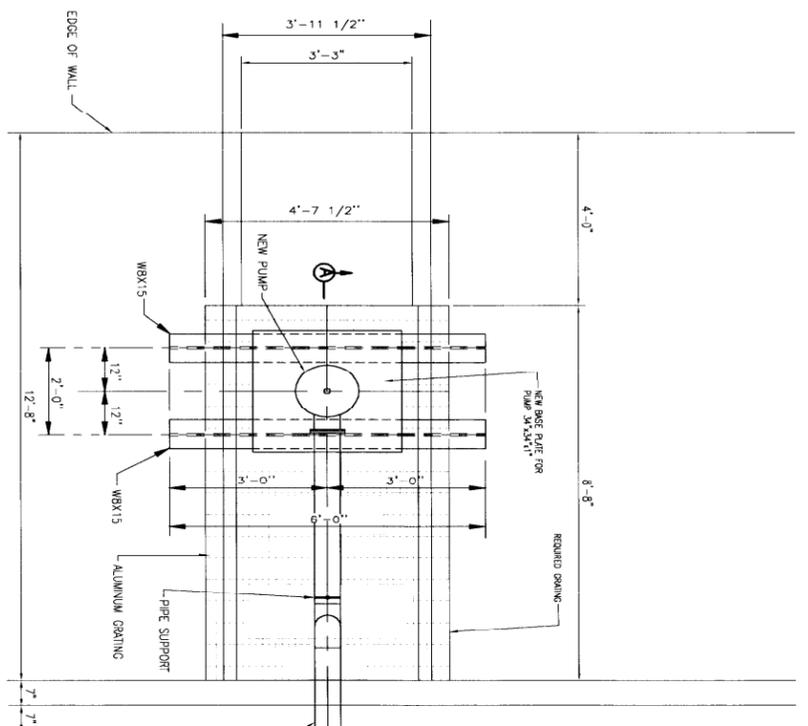


**PLAN - VALVE 18**  
SCALE 3/4"=1'-0"

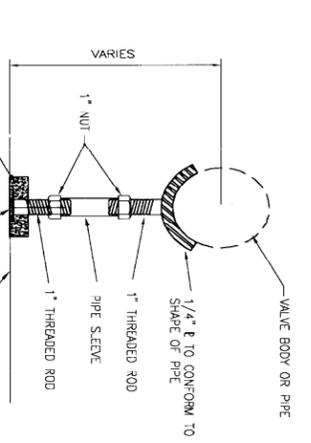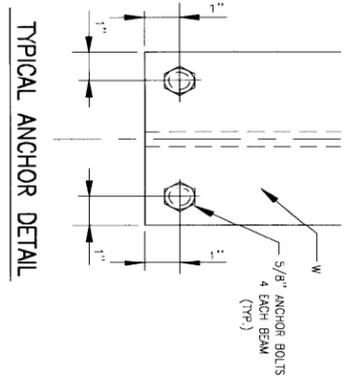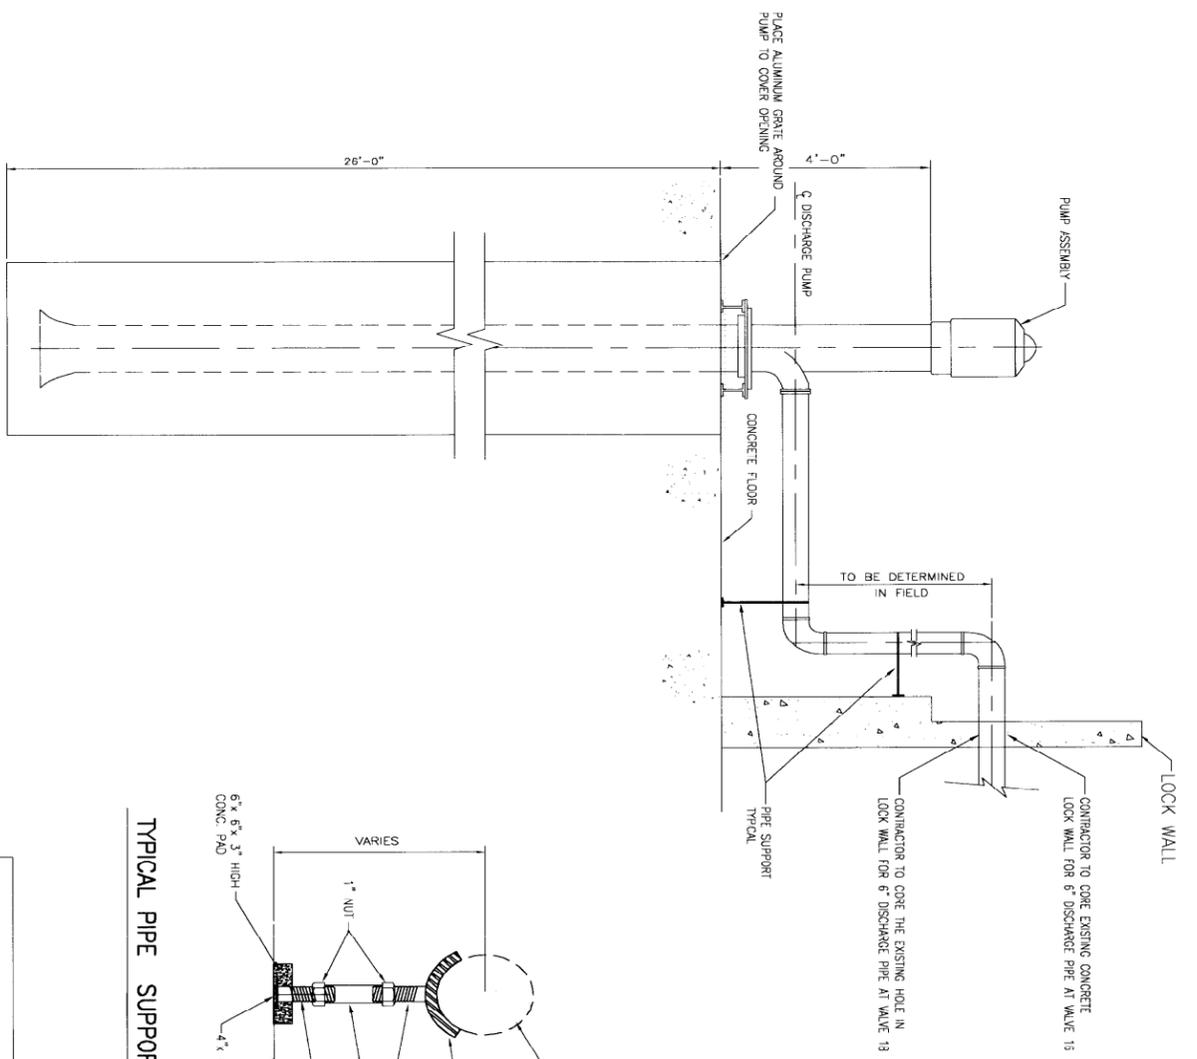


**SECTION (A)**  
SCALE 3/4"=1'-0"

**FOR CONSTRUCTION**  
FEB. 17, 2006

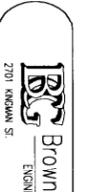


A B C D 1 2 3 4

**Safety is a Part  
of Your Contract**

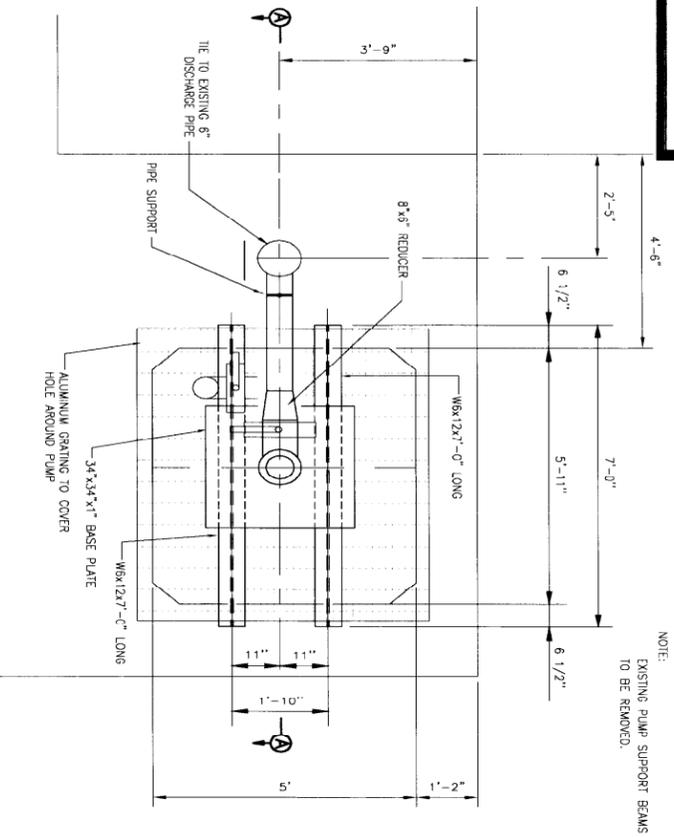


PLAN - SOUTH SUMP PUMP

SCALE 1/4"=1'-0"

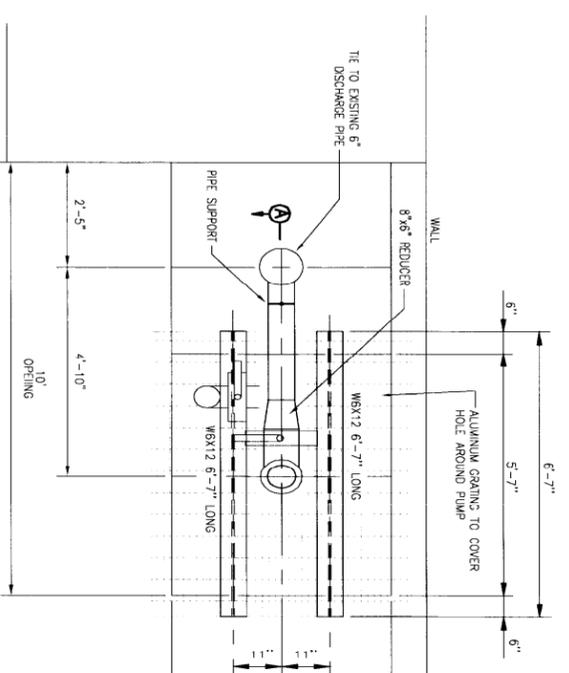


PLAN - NORTH SUMP PUMP

SCALE 1/4"=1'-0"

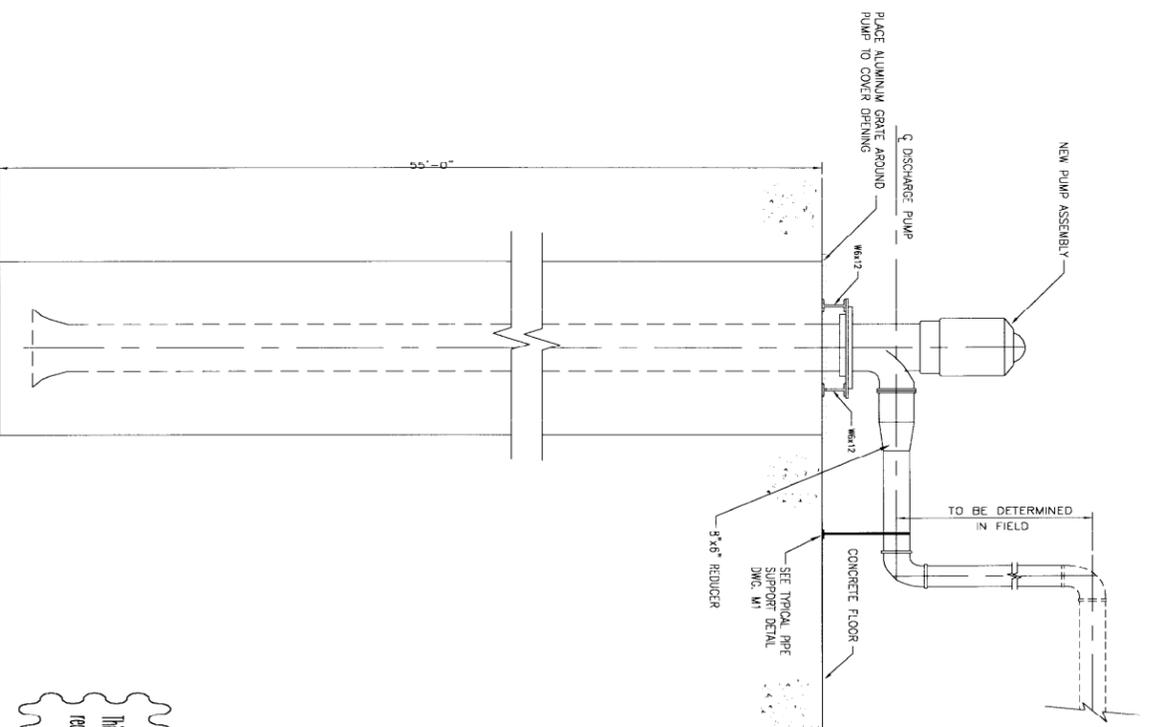

SECTION A

SCALE 1/4"=1'-0"

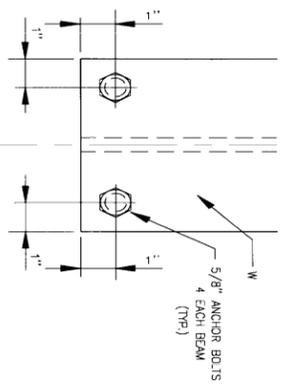

TYPICAL ANCHOR DETAIL

This drawing has been  
reduced to half size



FOR CONSTRUCTION  
FEB 17, 2006

